


Section 21 Township 8 Range 25W
Well No. 4 Schmied "C"
Company C. U. Bay

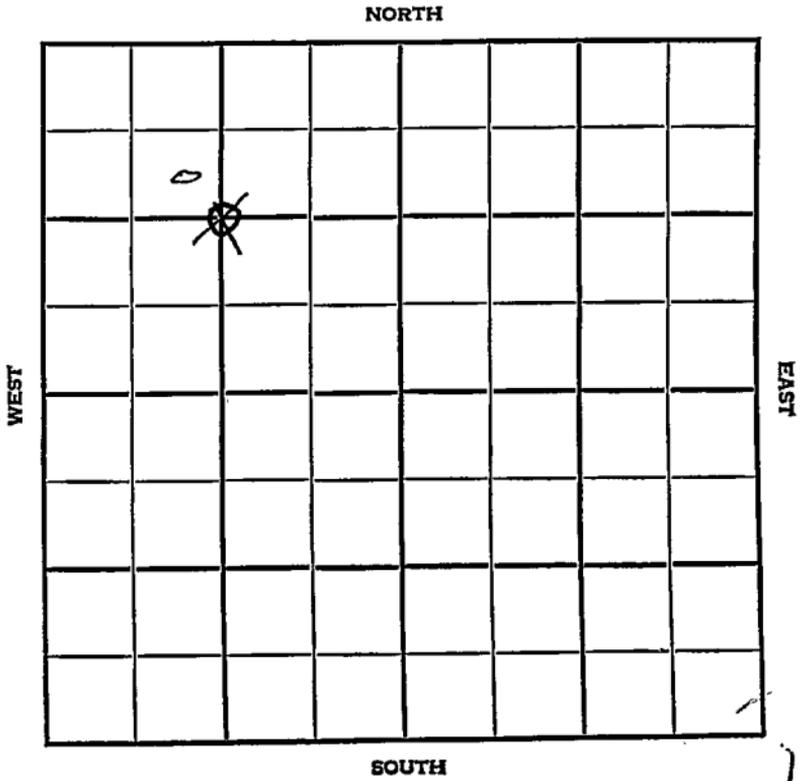

Graham

KANSAS

SEC.	TWP.	R.
21	8	25 W

WELL NO. # 4 Schmied "C" FARM

COMPANY C. U. Bay

CONTRACTOR Jackson


~~990~~ Schmied Pool
~~1320~~ Ft. from N. Line

Ft. from S. Line

Ft. from E. Line

~~990~~
~~1320~~ Ft. from W. Line

~~C NW/4~~
SE NW NW

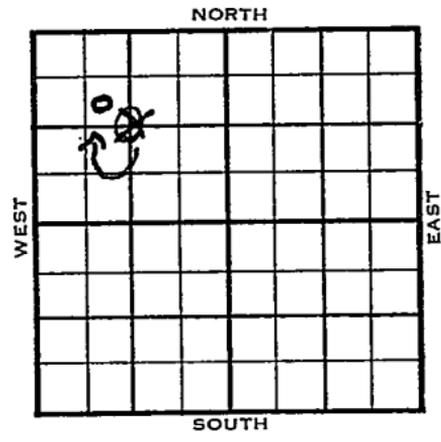

ELEVATION	REPORT
1954	2387'
10/6	Location
10/20	Spud 10-10-54 - D&A TD 3907' 8-5/8" @ 190' Heeb 3633', Tor 3656', Lans 3673' DST 3691-3712', opn 1 hr., rec. 700' muddy SW, 990# DST 3791-3812', opn 1 hr., rec. 20' mud, O# DST 3810-77', opn 1 hr., rec. 20' mud, O# TD 3907' D&A
	ABANDONED

Kansas

Map No. _____ Sec. 21 Twp. 8 R. 25W

Well No. 4 Schmeid "C"

C. U. Bay Company

Contractor _____

SE NW NW

SECTION PLAT

990 Ft. from N. Line

_____ Ft. from S. Line

_____ Ft. from E. Line

990 Ft. from W. Line

o			

Graham County

RECORD

Location _____

Cased _____ in., _____ ft.

Rig up _____

Sand _____

Drilling and Remarks:

Gas _____

Reported
C NW/4

Oil _____

Total Depth _____

PRODUCTION

1st 24 hrs. Nat. _____

1st 24 hrs. after shot _____

Gas _____ Cu. Ft.

Dry Hole _____

Abandoned _____

Date

OCT 20 1954

FADEN GILSTRAP
Scout

