


Section 21 Township 8 Range 23W

Well No. #1 McCoy

Company Derby Oil

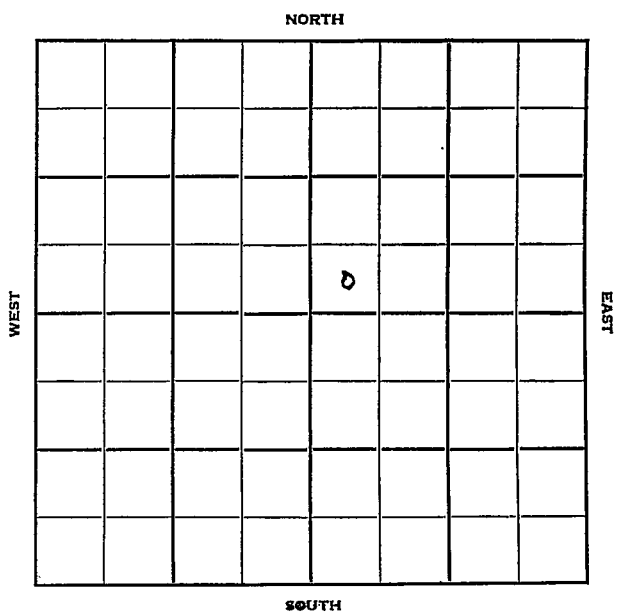

Graham

KANSAS

Sec. 21 Twp. 8 R. 23W


Well No. #1 McCoy Farm

Derby Oil Company

Peel Drlg. Contractor

Legere Pool

NORTH

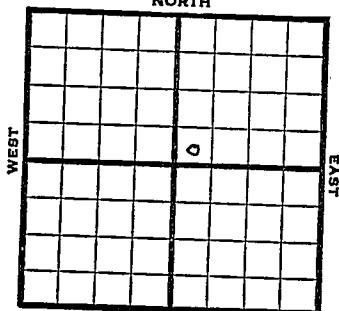

Ft. from N. Line

330 Ft. from S. Line

Ft. from E. Line

330 Ft. from W. Line

SW SW NE

SOUTH

1952

Elev. 2161' REPORT

1/2

Cellar & Pits

1/23

Spud 1-7-52

D & A TD 3745' 8" @ 300

Heeb 3463' Lans. 3504'

DST 3625-40 open $\frac{1}{2}$ hr. rec 2' mud


DST 3645-72 open $\frac{1}{2}$ hr. rec 5' mud

B KC 3723'

DST 3680-3725 open $\frac{1}{2}$ hr. rec 7' mud

TD 3745' D & A

ABANDONED

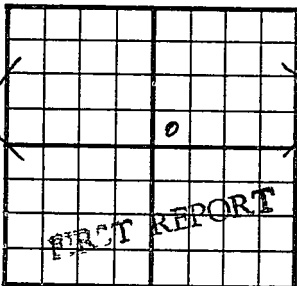County Graham State KansasSec. 21 (Blk.) 8 (Sur.) 23W Map No.Operator Derby OilWell No. 1 Farm McCoyElev. _____ Location SW SW NE330 Ft. From S Line NE330 Ft. From W Line Quarter1st. Report JAN 2 1952

Completion _____

Remarks _____


Spudding Date _____

Drig. Data _____

Legere PoolCellar & pits

J. E. TYRA

County Graham State Kansas
 Sec. 21 (Blk.) 8 (Sur.) 23W Map No.
 Operator Derby Oil
 Well No. 1 Farm McCoy
 Elev. 2161 Location SW SW NE

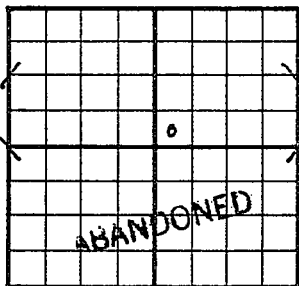

330 Ft. From S Line NE
330 Ft. From W Line Quarter
 Ist. Report
JAN 23 1952
 Completion
 Remarks Legere Pool
Peel Drlg. - Contr.
 Spudding Date 1-7-52

Drlg. Data D & A TD 3745

8" @ 300 Heeb. 3463 Lans. 3504

DST 3625-40 open $\frac{1}{2}$ hr. Rec. 2' mud

DST 3645-72 open $\frac{1}{2}$ hr. Rec. 5' mud

B KC 3723 DST 3680-3725 open $\frac{1}{2}$ hr.

Rec. 7' mud TD 3745

D & A

J. G. McGEHEE