

# KANSAS

FORM 51 5M 10-41 PETROL

Graham

Section 21 Township 8 Range 21-W

Well No. 1 Newell

Company Cities Service Oil

|  |  |  |  |  |  |  |  |  |  |
|--|--|--|--|--|--|--|--|--|--|
|  |  |  |  |  |  |  |  |  |  |
|  |  |  |  |  |  |  |  |  |  |
WEST EAST

NORTH Wildcat

SOUTH

0

**KANSAS**

Graham

Sec. 21 Twp. 8 R. 21-W

Well No. #1 Newell Farm

**Cities Service Oil**

Company

(Wildcat)


           Ft. from N. Line

330 Ft. from S. Line

           Ft. from E. Line

330 Ft. from W. Line

Elev. 2123

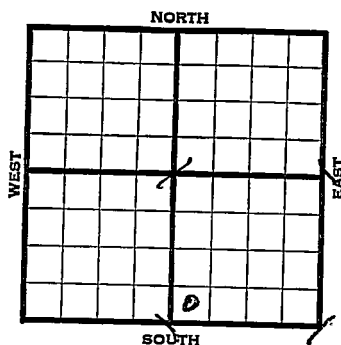

| 1941  | REPORT                                          |
|-------|-------------------------------------------------|
| 12/17 | Location                                        |
| 1942  |                                                 |
| 1/8   | "                                               |
| 1/15  | "                                               |
| 1/22  | 8" - 231' Drlg. 1525'                           |
| 1/29  | Anhy. 1640' Drlg. 3115'                         |
| 2/5   | Topeka 3063' Lans. 3334'                        |
|       | B.K.C. 3545' Arb. 3655'                         |
|       | T.D. 3700' Show heavy black oil.                |
| 2/12  | 4" - 3700' 23 shots 3679 $\frac{1}{2}$ to 3684' |
|       | 650' water. Shut down.                          |
|       |                                                 |
| 2/18  | Arb. 3655'                                      |
|       | 4 $\frac{1}{2}$ " - 3700'                       |
|       | T.D. 3700'                                      |
|       | 23 shots 3363-67'                               |
|       | Water.                                          |
|       |                                                 |
|       | <b>ABANDONED</b>                                |
|       |                                                 |
|       |                                                 |
|       |                                                 |
|       |                                                 |

Graham


KANSAS

Map No. 65 Sec. 21 Twp. 8 R. 21WWell No. 1 NewellCities Service Oil Company~~FIRST REPORT~~

Contractor

SW SE

## SECTION PLAT

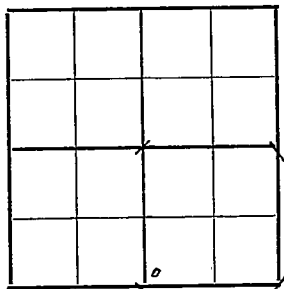

Ft. from N. Line

330 Ft. from S. Line

Ft. from E. Line

330 Ft. from W. Line

## WILDCAT

Location XX

Rig up

Drilling and Remarks: \*

## RECORD

Cased \_\_\_\_\_ in., \_\_\_\_\_ ft.

Sand \_\_\_\_\_

Gas \_\_\_\_\_

Oil \_\_\_\_\_

Total Depth \_\_\_\_\_

## PRODUCTION

1st 24 hrs. Nat. \_\_\_\_\_

1st 24 hrs. after shot \_\_\_\_\_

Gas \_\_\_\_\_ Cu. Ft.

Dry Hole \_\_\_\_\_

Abandoned \_\_\_\_\_

Date

DEC 17 1941

19

S. J. LEWIS

Scout

Graham

KANSAS

Map No. 65 Sec. 21 Twp. 8 R. 21WWell No. 1 Newell

Cities Service Oil Company

ABANDONED

Contractor

SW SE

## SECTION PLAT

|  |  |  |  |
|--|--|--|--|
|  |  |  |  |
|  |  |  |  |
|  |  |  |  |
|  |  |  |  |

o

Ft. from N. Line

330 Ft. from S. Line

Ft. from E. Line

330 Ft. from W. Line

WILDCAT

Location

Rig up

Drilling and Remarks:

*Cur 3655**4 1/2" @ 3700**2 3/4" to 3368-62**Water*

## RECORD

Cased \_\_\_\_\_ in., \_\_\_\_\_ ft.

Sand \_\_\_\_\_

Gas \_\_\_\_\_

Oil \_\_\_\_\_

Total Depth 3700

## PRODUCTION

1st 24 hrs. Nat. \_\_\_\_\_

1st 24 hrs. after shot \_\_\_\_\_

Gas \_\_\_\_\_ Cu. Ft.

Dry Hole \_\_\_\_\_

Abandoned \_\_\_\_\_

Date

FEB 18 1942

19

S. J. LEWIS Scout