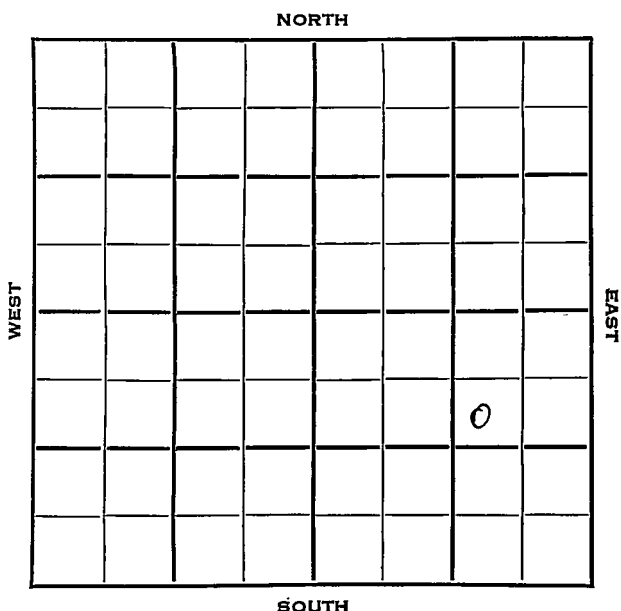


Section 21 Township 8 Range 21 WWell No. # 1 Newell "A"Company Mid-States Oil

Graham KANSAS

SEC.	TWP.	R.
21	8	21W

WELL NO.

1 Newell "A"

COMPANY

FARM

Mid-States Oil

CONTRACTOR

Gabbert-Jones

Wildcat

990

Ft. from N. Line


Ft. from S. Line

990

Ft. from E. Line

Ft. from W. Line

SW NE SE

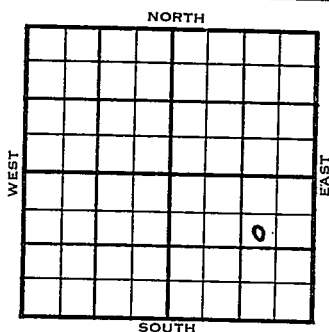

1953

ELEVATION

2115'

REPORT

12/16

Location

1954
1/6

Spud 12-19-53

D & A TD 3690 8" @ 1638

Anhy 1630 Top. 3080 Heeb 3293

Tor. 3318 Lans 3334

DST 3258-90 open 3/4 hr, rec 780' SW
1230#

DST 3360-80 open 1 hr rec 220' mud

DST 3412-35 open 1 hr rec 190' mud
830#DST 3493-3510 open 1 hr rec 5' SOCM
O# Cong. 3626 Arb. 3667

DST 3664-70, failed.

DST 3666-70 open 1 hr rec 10' mud

TD 3690' D & A

ABANDONED

County **Graham** State **Kansas**
 Sec. **21** (Blk.) **8** (Sur.) **21W** Map No.
 Operator **Mid-States Oil**
 Well No. **1** Farm **Newell "A"**
 Elev. Location **SW NE SE**

FIRST REPORT

990 Ft. From **N** Line **SE**
 990 Ft. From **E** Line Quarter

1st. Report **DEC 16 1953**

Completion

Remarks

Gabbert-Jones - Contr.

Spudding Date


Wildcat

Drlg. Data

Location

J. G. McGEHEE

County Graham State Kansas
 Sec. 21 (Blk.) 8 (Sur.) 21W Map No.
 Operator Mid-States Oil
 Well No. 1 Farm Newell "A"
 Elev. 2115 Location SW NE SE

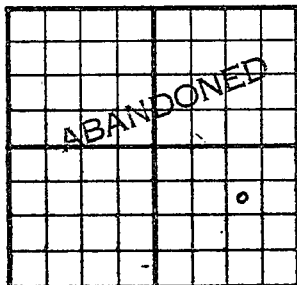

990 Ft. From N Line SE
990 Ft. From E Line Quarter
 1st. Report
 Completion JAN 6 1954
 Remarks Wildcat
Gabbert-Jones - Contr.
 Spudding Date 12-19-53

Dflg. Data D & A TD 3690
8" @ 1638 Anhy 1630 Top. 3080
Heeb. 3293 Tbn. 3318 Lans. 3334
DST 3258-90 open 3/4 hr. Rec. 780' sw
1230# DST 3360-80 open 1 hr.
Rec. 220' mud DST 3412-35 open 1 hr.
Rec. 190' mud 830# DST 3493-3510
open 1 hr. Rec. 5' socm 0# Cong. 3626
Arb. 3667 DST 3664-70 failed
DST 3666-70 open 1 hr. Rec. 10' mud
TD 3690

D & A

J. G. McGEHEE