



SIDE ONE

35-8-22 W

STATE CORPORATION COMMISSION OF KANSAS
OIL & GAS CONSERVATION DIVISIONWELL COMPLETION OR RECOMPLETION FORM
ACO-1 WELL HISTORY

DESCRIPTION OF WELL AND LEASE

Operator: License # 8925
 Name Liberty Operations & Completions, Inc.
 Address 308 West Mill
 City/State/Zip Plainville, Ks 67663

Purchaser.....

Operator Contact Person Charles G. Comeau
 Phone 913-434-4686

Contractor: License # 5665
 Name Pioneer Drilling Company, Inc.

Wellsite Geologist Greg Issinghoff
 Phone 913-628-3503

Designate Type of Completion

☒ New Well ☐ Re-Entry ☐ Workover
☐ Oil ☐ SWD ☐ Temp Abd
☐ Gas ☐ Inj ☐ Delayed Comp
☒ Dry ☐ Other (Core, Water Supply etc.)

If ONWO: old well info as follows:

Operator
 Well Name
 Comp. Date Old Total Depth.....

WELL HISTORY

Drilling Method:

☒ Mud Rotary ☐ Air Rotary ☐ Cable

7-25-85 8-01-85 8-01-85
 Spud Date Date Reached TD Completion Date
 3840'
 Total Depth PBDT

8 5/8" @ 243'

Amount of Surface Pipe Set and Cemented at.....feet
 Multiple Stage Cementing Collar Used? ☐ Yes ☐ No

If yes, show depth set.....feet

If alternate 2 completion, cement circulated
 from.....feet depth to.....w/.....SX cmt

API NO. 15-065-22,181

County.....Graham

SW NE NW 35 8s 22 ☐ East
 Sec.....Twp.....Rge.....☒ West

4290
 3630
 Ft North from Southeast Corner of Section
 Ft West from Southeast Corner of Section

(Note: Locate well in section plat below)


Lease Name.....Buss Well #.....1

Field Name.....

Producing Formation.....

Elevation: Ground.....2174'.....2179'
 KB.....

Section Plat

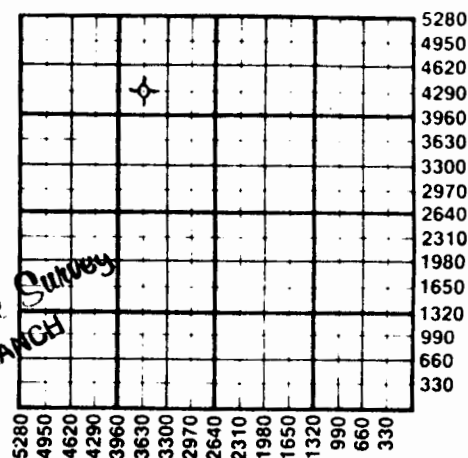

WATER SUPPLY INFORMATION

Disposition of Produced Water: ☐ Disposal
 Docket # ☐ Repressuring

Questions on this portion of the ACO-1 call:

Water Resources Board (913) 296-3717

Source of Water:

Division of Water Resources Permit #.....

☐ Groundwater.....1320 Ft North from Southeast Corner
 (Well) ..1320 Ft West from Southeast Corner of
 Sec 14 Twp 8S Rge 22 ☐ East ☒ West

☐ Surface Water.....Ft North from Southeast Corner
 (Stream, pond etc).....Ft West from Southeast Corner
 Sec Twp Rge ☐ East ☐ West

☐ Other (explain).....
 (purchased from city, R.W.D. #)

INSTRUCTIONS: This form shall be completed in duplicate and filed with the Kansas Corporation Commission, 200 Colorado Derby Building, Wichita, Kansas 67202, within 90 days after completion or recompletion of any well. Rule 82-3-130 and 82-3-107 apply.

Information on side two of this form will be held confidential for a period of 12 months if requested in writing and submitted with the form. See rule 82-3-107 for confidentiality in excess of 12 months.

One copy of all wireline logs and drillers time log shall be attached with this form. Submit CP-4 form with all plugged wells. Submit CP-111 form with all temporarily abandoned wells.