

HAVE LOG


KANSAS CORPORATION COMMISSION

WELL RECORD

36-8-22W

15-065-20513

(Mail to Kansas Geological Survey, 4150 Monroe Street, Wichita, Kansas 67209)

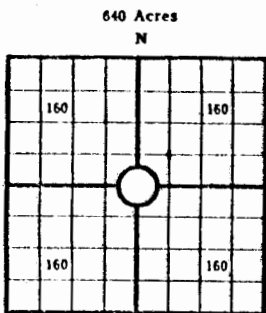

Locate well correctly

Lease Name: Buss Well No. 1
 Well Located: SE SW NW
SEC 36 TWP 8S RGE 22W
 Operator: K & E Drilling, Inc.
 Address: 816 Union Center, Wichita, Kansas 67202
 Elevation: Ground 2159 D.F. K.B. 2164
 Type Well: (Oil, gas, dry hole) Dry Hole

Drilling Commenced: 1/1 19 72 Drilling Completed: 1/8 19 72
 Well Completed: ----- 19 -- Total Depth 3620'
 Initial Production: -----

Casing Record

Size: ----- Set at ----- Size: ----- Set at -----
 Size: 8-5/8" Set at 215' Size: ----- Set at -----

Liner Record

Size: ----- Set from ----- To -----

Cementing

<u>Casing Size</u>	<u>Sacks</u>	<u>Type Cement and Additives</u>
<u>8-5/8"</u>	<u>145 sx.</u>	<u>-----</u>
<u>-----</u>	<u>-----</u>	<u>-----</u>
<u>-----</u>	<u>-----</u>	<u>-----</u>

Perforations

<u>Formation</u>	<u>Perforated Interval and Number Shots</u>
<u>-----</u>	<u>-----</u>
<u>-----</u>	<u>-----</u>
<u>-----</u>	<u>-----</u>

Electric Log Run (Show type log and depths covered)

NONE

Show Drill Stem Tests,
Well Stimulation and
Production Tests

Formation Top Bottom

Surface Hole	0	218'
Shale & Sand	218'	450'
Shale & Sand	450'	1296'
Shale & Sand	1296'	1686'
Anhydrite	1686'	1718'
Shale & Sand	1718'	1850'
Shale & Red Bed	1850'	2180'
Shale & Lime	2180'	2620'
Shale & Lime	2620'	3170'
Lime & Shale	3170'	3295'
Lime	3295'	3620'
Total Depth		3620'

Pg. 2

36-8-22W

D.S.T. #1 3458-3482'. 30-30-60-30.
Rec. 480' muddy water. BHP 1198-1194#.
IFP 21-107#. FFP 121-247#.

D.S.T. #2 3555-3601'. 30-30-30-30.
Rec. 70' watery mud w/few specks oil.
BHP 1223-1161#. IFP 37-41#. FFP 47-58#.

SMP TOPS	DEPTH
ANHY	1686
B ANHY	1718
TOP	3125
HEEB	3353
TOR	3378
LKC	3396
BKC	3601
RTD	3620



55270