


Rock

Section 22 Township 8 Range 19-W

Well No. #1 Green "B"

Company W. L. Hartman

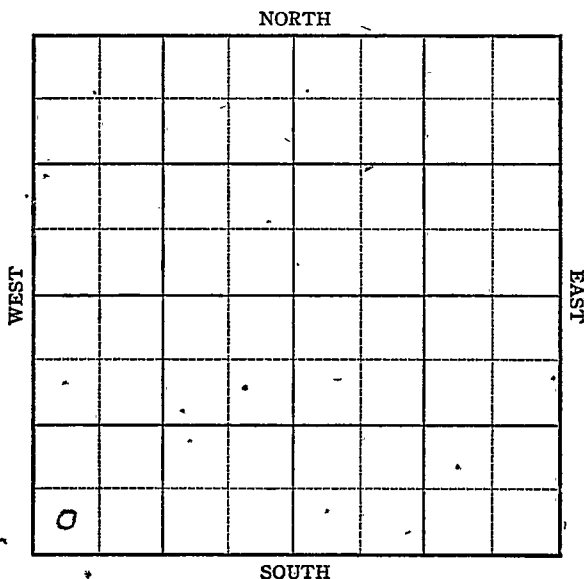

KANSAS

Rooks County

Sec. 22 Twp. 8 R. 19W

Well No. 1 Green "B" Farm

W. L. Hartman Company

Ververka Pool


Ft. from N. Line

330 Ft. from S. Line

Ft. from E. Line

330 Ft. from W. Line

SW/C

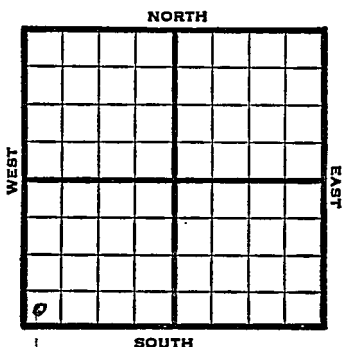

1947 Elev. 1987: REPORT

7-9 Loc.

7-16 Drlg. 3250

7/22 Topeka 2936'
Lansing 3172'
Arbuckle 3413' 14 1/2 T.D.
5" @ 3413'
RUST

7/29 " "

8/6 TD 3415'
Swb 14 bbls oil PH 4 hrs.

8/13 Pumped 12 bbls. oil PH.

8/20 "

8/27 "

9/3 "

9/10 Arbuckle 3413'
5" @ 3413 '
Pump 311 Pot.
Gr. 270
Total Depth 3415'

COMPLETED

Map No. 65 Sec. 22 Twp. 8 R. 19W

Well No. 1 Green "B"

FIRST REPORT W. R. Hoffman Company

CORRECTION _____ Contractor

SW/C


SECTION PLAT

_____ Ft. from N. Line

330 Ft. from S. Line

_____ Ft. from E. Line

330 Ft. from W. Line

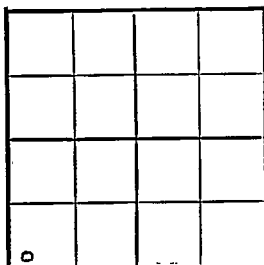

Rooks County

Location ✓

Rig up _____

Drilling and Remarks:

Had spotted in

SE/C

RECORD

Cased _____ in _____ ft.

Sand _____

Gas _____

Oil _____

Total Depth _____

PRODUCTION

1st 24 hrs. Nat. _____

1st 24 hrs. after shot _____

Gas _____ Cu. Ft.

Dry Hole _____

Abandoned _____

Date

JUL 9 1947 19 S. J. LEWIS Scout

Map No. 65 Sec. 22 Twp. 8 R. 19W

Well No. 1 Green "B"


W. L. Hartman Company

COMPLETE

Contractor

SW/C

E 1, 1987
SECTION PLAT

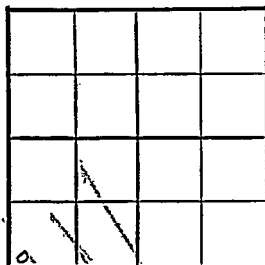

 Ft. from N. Line

330 Ft. from S. Line

 Ft. from E. Line

330 Ft. from W. Line

Rooks County

RECORD

Location

Rig up

Drilling and Remarks:

Cased in., ft.

Sand

Gas

Oil

Total Depth 345

PRODUCTION

1st 24 hrs. Nat.

1st 24 hrs. after shot

Gas Cu. Ft.

Dry Hole

Abandoned

Date

SEP 10 1947 19

S. J. LEWIS

Scout