


KANSAS

Section 22 Township 8 Range 19-W

Well No. #2 Peterson

Company W. L. Hartman

NORTH

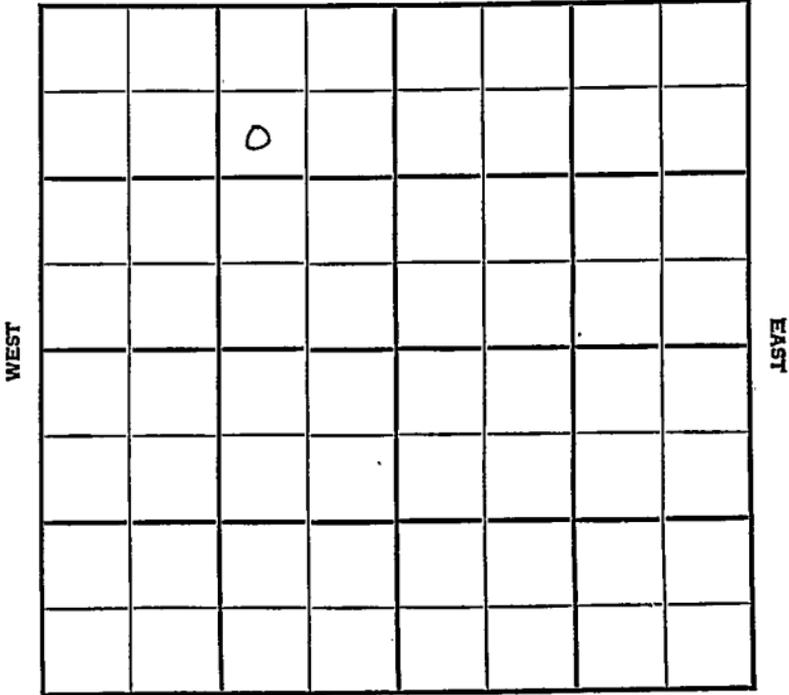

SOUTH

Sec. 22 Twp. 8 R. 19W

Well No. #2 Peterson Farm

W. L. Hartman Company

Webster Pool


990' Ft. from N. Line

_____ Ft. from S. Line

990' Ft. from E. Line

_____ Ft. from W. Line

SW NE NW

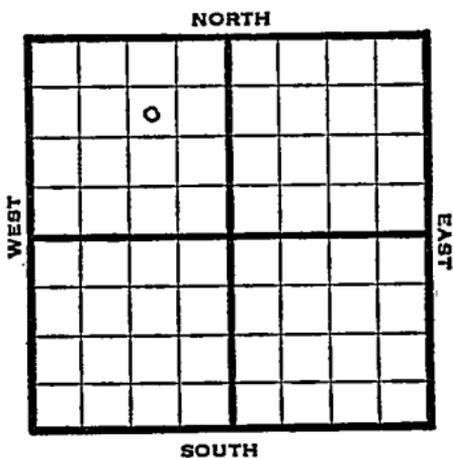

1948

Eli 1990'

R E P O R T

7/8

RUR

7/14

8" @ 127'

Dr lg 2520'

7/21

Arb. 3428'

TD 3429'

5" @ 3428

RUST

7/28

TD 3431'

500 acid

8/4

TD 3435' - 500 acid

1100' oil 12 hrs.

8/11

" "

8/18

" "

8/24

" "

9/1

Arb. 3428'

5" @ 3428'

TD 3435'

1000 acid

Pump 209 oil / 3 % W Pot

28 Gr.

Comp

COMPLETED

Webster Pool

Form 26—200 Bks.—1-48—Palace
Kansas

Map No. _____ Sec. 22 Twp. 8 R. 19W

Well No. 2 Peterson

W. L. Hartman Company

FIRST REPORT Contractor

SW NE NW

SECTION PLAT

990 Ft. from N. Line

_____ Ft. from S. Line

990 Ft. from E. Line

_____ Ft. from W. Line

	o		

Rooks County

Location _____

Rig up _____

Drilling and Remarks:

R U R

RECORD

Cased _____ in., _____ ft.

Sand _____

Gas _____

Oil _____

Total Depth _____

PRODUCTION

1st 24 hrs. Nat. _____

1st 24 hrs. after shot _____

Gas _____ Cu. Ft.

Dry Hole _____

Abandoned _____

Date

JUL 8 1948 19

S. J. LEWIS Scout

Rooks County Kansas State

Map No. 65 Sec. 22 Twp. 8 R. 19W

Well No. 2 Peterson

W. L. Hartman Company

COMPLETE

Contractor

SW NE NW

E. 1990
SECTION PLAT

990 Ft. from N. Line

Ft. from S. Line

990 Ft. from E. Line

Ft. from W. Line

Webster Pool

Remarks:

CR 3428

5" @ 3428

TI 3435

1000 Acid

Pump. 209 oil + 3% W.B.D

28 Gr

Date SEP 1 1948

Scout S. J. LEWIS