


# KANSAS

Section 22 Township 8 Range 19W

Well No. #1 Peterson

Company W.L. Hartman

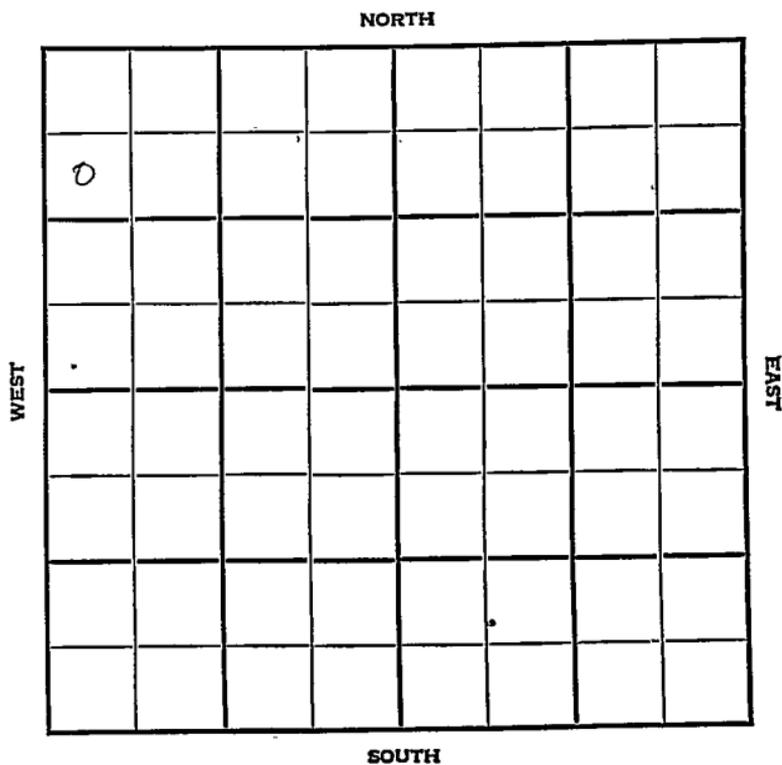



Sec. 22 Twp. 8 R. 19W

Well No. #1 Peterson Farm  
W. L. Hartman Company

Ververka


           Ft. from N. Line

990 Ft. from S. Line

           Ft. from E. Line

330 Ft. from W. Line

NW SW NW

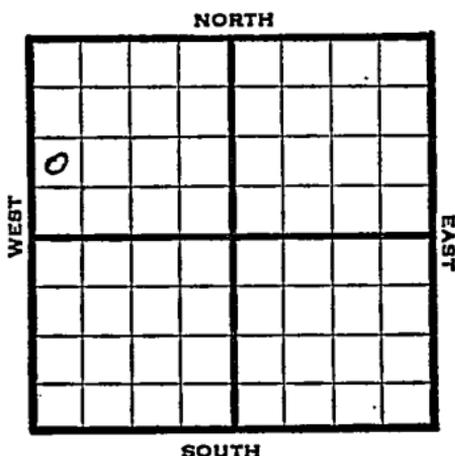

1947

Elev. 2004' REPORT

11/19

Location.

11/25

10" @ 187'  
WOC

12/3

Drig. 3240'

12/10

Lansing 3183'  
Arbuckle 3449'  
5" @ 3449'  
RUST  
TD 3456'

12/17

"

12/30

Pump 100` bbls. oil PH 5 hrs.

1948

1/7

Arbuckle 3449'  
5" @ 3449'  
Pump 168 Pot.  
Gr. 37°  
Total Depth 3456'

**COMPLETED**

Map No. \_\_\_\_\_ Sec. 22 Twp. 8 R. 19W

Well No. 1 Peterson

W. L. Hartman Company

FIRST REPORT

Contractor

NW SW NW


SECTION PLAT

\_\_\_\_\_ Ft. from N. Line

990 Ft. from S. Line

\_\_\_\_\_ Ft. from E. Line

330 Ft. from W. Line

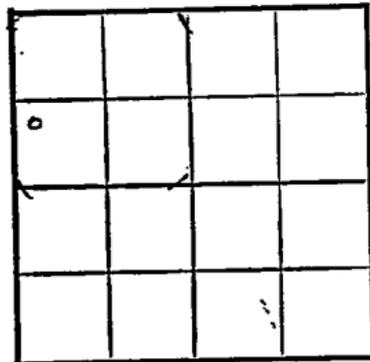

Rooks County

Location X

Rig up \_\_\_\_\_

Drilling and Remarks:

RECORD

Cased \_\_\_\_\_ in., \_\_\_\_\_ ft.

Sand \_\_\_\_\_

Gas \_\_\_\_\_

Oil \_\_\_\_\_

Total Depth \_\_\_\_\_

PRODUCTION

1st 24 hrs. Nat. \_\_\_\_\_

1st 24 hrs. after shot \_\_\_\_\_

Gas \_\_\_\_\_ Cu. Ft.

Dry Hole \_\_\_\_\_

Abandoned \_\_\_\_\_

Date

NOV 1 9 1947 19

S. J. LEWIS Scout

