

KANSAS Rooks

Section 22 Township 8 Range 19WWell No. 3 PetersonCompany Northern Pump

Barry Pool

NORTH

		0					

WEST

EAST

SOUTH

KANSAS

Rooks



Sec. 22 Twp. 8 R. 19W

Well No. #3 Peterson Farm

Northern Pump Company

Barry Pool


Ft. from N. Line.

990' Ft. from S. Line

990' Ft. from E. Line

Ft. from W. Line

NW SE NW

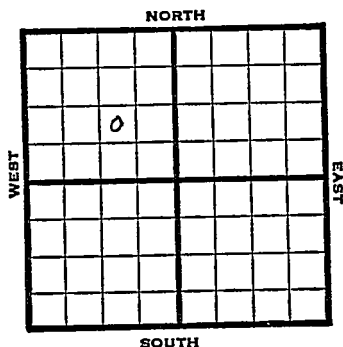

1948

Eli 1999

REPORT

10/27

Location

11/3

8" @ 170'

Drlg. 2825'

10/11

Lansing 3192'

Arbuckle 3438'

TD 3444'

SO

5" @ 3440'

11/16

Drlg. 3463'

11/23

TD 3475'

180' fluid

11/30

PB 3457- 1500 acid

12/8

TD 347'

Arb. 3438'

Aband.

ABANDONED

Map No. _____ Sec. 22 Twp. 8 R. 19W

Well No. 3 Peterson

Northern Pump

Company

FIRST REPORT

Contractor

NW SE NW


SECTION PLAT

_____ Ft. from N. Line

990 Ft. from S. Line

990 Ft. from E. Line

_____ Ft. from W. Line

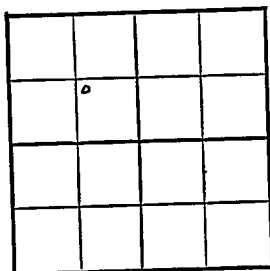

Rooks County

Location X

Rig up _____

Drilling and Remarks:

RECORD

Cased _____ in. _____ ft.

Sand _____

Gas _____

Oil _____

Total Depth _____

PRODUCTION

1st 24 hrs. Nat. _____

1st 24 hrs. after shot _____

Gas _____ Cu. Ft.

Dry Hole _____

Abandoned _____

Date

OCT 27 1948

S. J. LEWIS

Scout

Map No. 65 Sec. 22 Twp. 8 R. 19W

Well No. 3 Peterson

Northern Pump Company

ABANDONED Contractor

NW SE NW


E/1998
SECTION PLAT

 Ft. from N. Line

990 Ft. from S. Line

990 Ft. from E. Line

 Ft. from W. Line

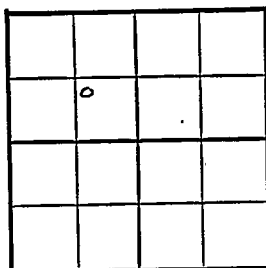

Rooks County

Location

Rig up

Drilling and Remarks:

Art 3408.

RECORD

Cased in., ft.

Sand

Gas

Oil

Total Depth 247

PRODUCTION

1st 24 hrs. Nat.

1st 24 hrs. after shot

Gas Cu. Ft.

Dry Hole

Abandoned

Date

DEC 8 1948 19 S. J. LEWIS Scout