


Section 22 Township 8 Range 19W

Well No. 4 Peterson

Company Northern Pump

Barry Pool  
NORTH

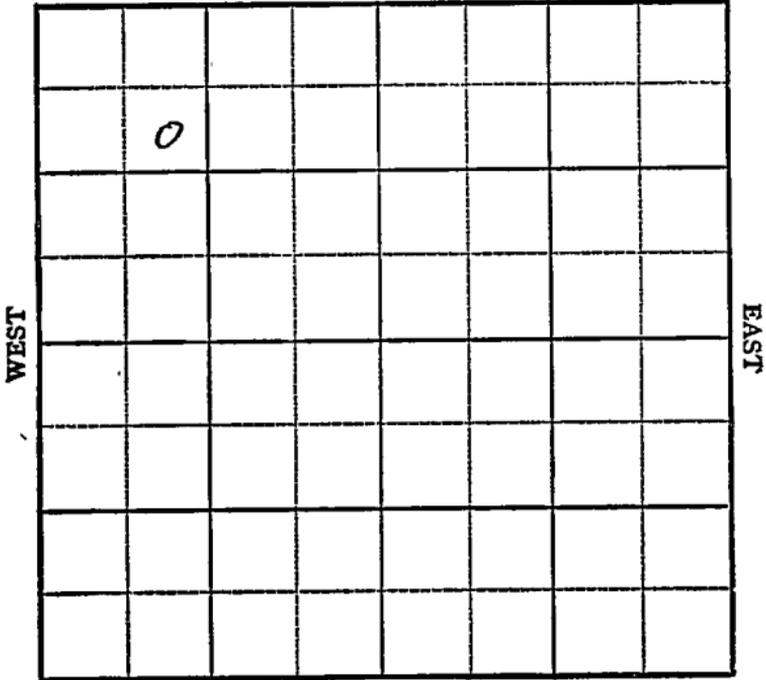

SOUTH



Sec. 22 Twp. \_\_\_\_\_ R. 19W

Well No. #4 Peterson Farm \_\_\_\_\_  
Northern Pump Company

Barry Pool


990' Ft. from N. Line

\_\_\_\_\_ Ft. from S. Line

\_\_\_\_\_ Ft. from E. Line

990' Ft. from W. Line

SE NW NW

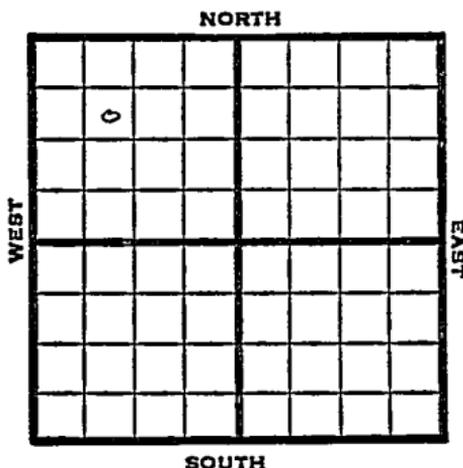

1948 Eli 1974' REPORT

11/10 8" @ 150'  
11/16 Lansing 3167'  
Arbuckle 3423'  
TD 3427'  
11/23 Arb 3418'  
5" @ 3418'  
11/30 "  
12/8 TD 3428  
500 acid  
700' oil / 150' W 12 hrs.  
12/15 "  
12/22 "  
12/29 "  
1 / 5 "  
1/12 "  
1/19 TD 3428'  
Arb. 3418'  
5" @ 3418'  
500 acid  
Pump 25 oil Pot  
31° Gr.  
Comp

**COMPLETED**

Map No. \_\_\_\_\_ Sec. 22 Twp. 8 R. 19W

Well No. 4 Peterson

Northern Pump Company

### FIRST REPORT

Contractor

SE NW NW

### SECTION PLAT

990 Ft. from N. Line  
\_\_\_\_\_ Ft. from S. Line  
\_\_\_\_\_ Ft. from E. Line  
990 Ft. from W. Line


Becks County

Location \_\_\_\_\_

Rig up \_\_\_\_\_

Drilling and Remarks:

8" @ 150

### RECORD

Cased \_\_\_\_\_ in., \_\_\_\_\_ ft.

Sand \_\_\_\_\_

Gas \_\_\_\_\_

Oil \_\_\_\_\_

Total Depth \_\_\_\_\_

### PRODUCTION

1st 24 hrs. Nat. \_\_\_\_\_

1st 24 hrs. after shot \_\_\_\_\_

Gas \_\_\_\_\_ Cu. Ft.

Dry Hole \_\_\_\_\_

Abandoned \_\_\_\_\_

Date

NOV 10 1948 19

S. J. LEWIS Scout

