

KANSAS

Rooks

Section 22 Township 8 Range 19W

Well No. 1 Sayers

Company Northern Ordnance

Silvers Pool

NORTH.

WEST

EAST

0

SOUTH

Sec. 22 Twp. 8 R. 19W

Well No. #1 Sayers Farm

Northern Ordnance Company

Silvers Pool


990' Ft. from N. Line

_____ Ft. from S. Line

_____ Ft. from E. Line

330' Ft. from W. Line

SW NW SW

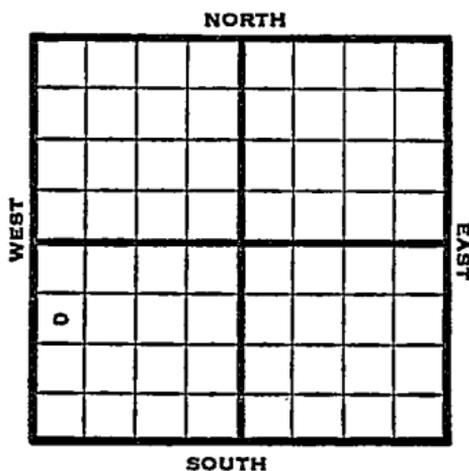

1948

Eli 2005'

REPORT

11/23

8" @ 165'

Drlg. 2710'

11/30

Lansing 3199'

BKG 3408'

Arb. 3456-58'

TD 3458'

5" @ 3456'

12/8

TD 3460' 500 acid

12/15

300' oil / 350' W in 8 hrs.

12/22

"

12/29

"

1/5

"

1/12

"

1/19

TD 3460'

Arb. 3456'

5" @ 3456'

500 acid

Pump 11 oil / 30 W Pot

29° Gr.

Comp

COMPLETED

Map No. _____ Sec. 22 Twp. 8 R. 19W

Well No. 1 Sayers

Northern Ordnance Company

FIRST REPORT

SW NW SW Contractor

SECTION PLAT

990 Ft. from N. Line

_____ Ft. from S. Line

_____ Ft. from E. Line

330 Ft. from W. Line

Rooks County

Location _____

Rig up _____

Drilling and Remarks:

8" @ 165

drlg. 2710

RECORD

Cased _____ in., _____ ft.

Sand _____

Gas _____

Oil _____

Total Depth _____

PRODUCTION

1st 24 hrs. Nat. _____

1st 24 hrs. after shot _____

Gas _____ Cu. Ft.

Dry Hole _____

Abandoned _____

Date

NOV 23 1948

19

S. J. LEWIS Scout

Kansas

Map No. 65 Sec. 22 Twp. 8 R. 19TH

Well No. 1 Savers

Northern Ordnance

Company

COMPLETE

SW NW SW

Contractor

E. 2005

SECTION PLAT

990 Ft. from N. Line

_____ Ft. from S. Line

_____ Ft. from E. Line

330 Ft. from W. Line

Rooks County

Location _____

Rig up _____

Drilling and Remarks:

Cr 13456
5" @ 3456
500 cu ft
Pump 11 oil + 30 W
Bx
29 2/3

RECORD

Cased _____ in., _____ ft.

Sand _____

Gas _____

Oil

Total Depth 2460

PRODUCTION

1st 24 hrs. Nat _____

1st 24 hrs. after shot _____

Gas _____ Cu. Ft.

Dry Hole _____

Abandoned _____

Date

JAN 19 1949:

19

S. J. LEWIS

Scout