


DX 78-1

Graham

Section 22 Township 8 Range 25W

Well No. #1 St. John

Company Peel Hardman Oil Prod.

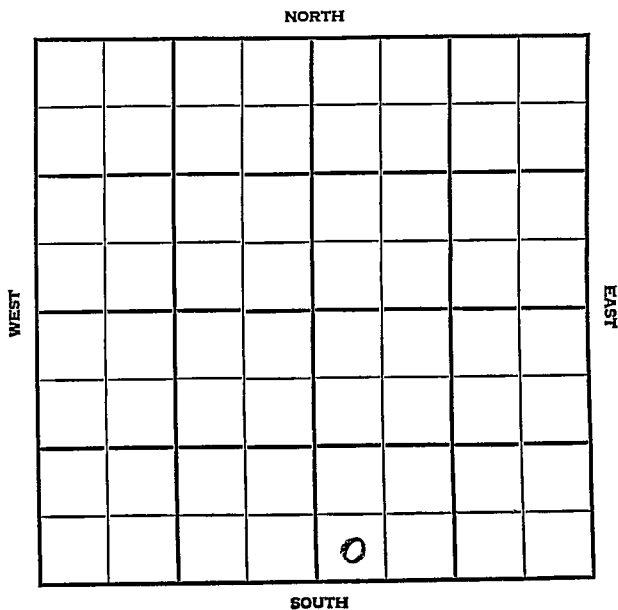

Graham

KANSAS

SEC.	TWP.	R.
22	8	25W

WELL NO.

1 St. John

FARM

COMPANY

Peel Hardman Oil Prod.

CONTRACTOR

Wildcat

_____ Ft. from N. Line


330' _____ Ft. from S. Line

_____ Ft. from E. Line

330' _____ Ft. from W. Line

Bay Pet. - FO

SW SW SE

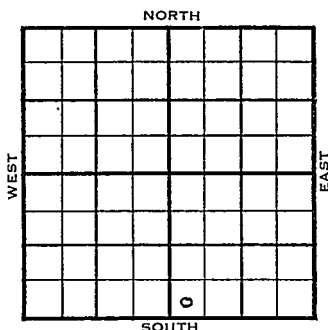

1955	ELEVATION	REPORT
------	-----------	--------

6/1 Spud 5-26-55
8" @ 160 w/125
Drlg 3300'

6/8 Comm 5-26-55
H 3676, L 3717, TD 3960
8" @ 160/125, DST 3735-63 open 1 hr
Rec 100' drlg mud 1185/15"
DST 3781-3802 open 1 hr Rec 220' wtr
1125/15"
DST 3836-68 open $\frac{1}{2}$ hr Rec 36' muddy
oil 0/15" DST 3861-3910 open $\frac{1}{2}$ hr.
Rec 20' mud 0/15"
D & A

ABANDONED

County Graham ✓ Elev. 2403
 Sec. 22 Twp. 8 Rge. 2 5W
 Company Peel-Hardman Oil Prod.
 Farm Name St. John's No. 1

TOPS	DEPTH	LOG	DATUM
Anh.			
Tp.			
H.	3676		1273
Tr.			
Dg.			
Bl.			
L.	3717		1314
K.C.			
B.K.C.			
Ce.			
C.			
M.			
M.			
K.			
Mz.			
Me.			
V.			
S.			
S.			
A.			
R.			
PE.			
G.			
T.D.	3960		

Loc. in Sec. SW SW SE

Geol. _____

Contr. _____

Pool _____

Wildcat

Date Comm. 5-26-55 JUN 8 1955

8" @ 160/125 DST 3735-63 open 1 hr.

Rec. 100' drlg. mud 1185/15" DST 3781-

3802 open 1 hr. Rec. 220' wtr. 1185/

15" DST 3836-68 open 1/2 hr. Rec.

36' muddy oil 0/15" DST 3861-3910

open 1/2 hr. Rec. 20' mud 0/15"

D & A

Co.

Lse.

No.

Sec.

T.

R.