

KANSAS


FORM 51 5M BR1X

Graham

Section 22 Township 8 Range 21W

Well No. #1 Newall (23 Strat)

Company Continental

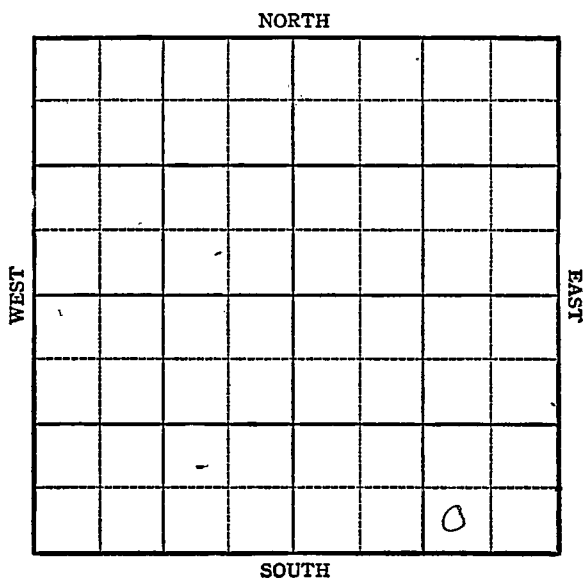

KANSAS


Graham

Sec. 22 Twp. 8 R. 21W

Well No. #1 Newall (23 Strat) Farm
Continental Company

Wildcat

NORTH

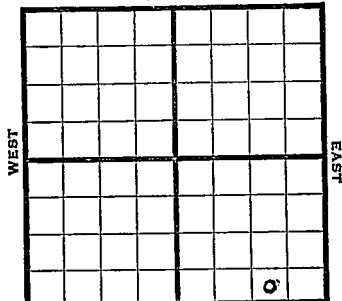

SOUTH

 Ft. from N. Line

330' Ft. from S. Line

990' Ft. from E. Line

 Ft. from W. Line

1944

REPORT

6/21 Drlg.
6/28 "

7/19 No tops or depths.

ABANDONED

Pool Name WildcatMap No. 65 Sec. 22 Twp. 8 R. 21WWell No. 1 Newall (23 Strat)

Continental Company

FIRST REPORT

Contractor

SECTION PLAT

SW SE SE

Ft. from N. Line

330 Ft. from S. Line

990 Ft. from E. Line

Ft. from W. Line

Graham

RECORD

Location

Cased _____ in., _____ ft.

Rig up

Sand _____

Drilling and Remarks:

Gas _____

Drlg.

Oil _____

Total Depth _____

PRODUCTION

1st 24 hrs. Nat. _____

1st 24 hrs. after shot _____

Gas _____ Cu. Ft.

Dry Hole _____

Abandoned _____

Date

JUN 21 1944 19

S. J. LEWIS Scout

Pool Name WildcatMap No. KANSAS Sec. 22 Twp. 8 R. 21WWell No. 1 Newall (23 Strat)Continental CompanyABANDONED Contractor

SW SE SE

SECTION PLAT

 Ft. from N. Line330 Ft. from S. Line990 Ft. from E. Line Ft. from W. LineGraham CountyLocation Rig up

Drilling and Remarks:

*No Top
or Depths*

RECORD

Cased in., ft.Sand Gas Oil Total Depth

PRODUCTION

1st 24 hrs. Nat. 1st 24 hrs. after shot Gas Cu. Ft.Dry Hole Abandoned to ac

Date

JUL 19 1944 19 S. J. LEWIS Scout