


Section 22 Township 8 Range 21W

Well No. #1 Mewere 24 Strat

Company Continental

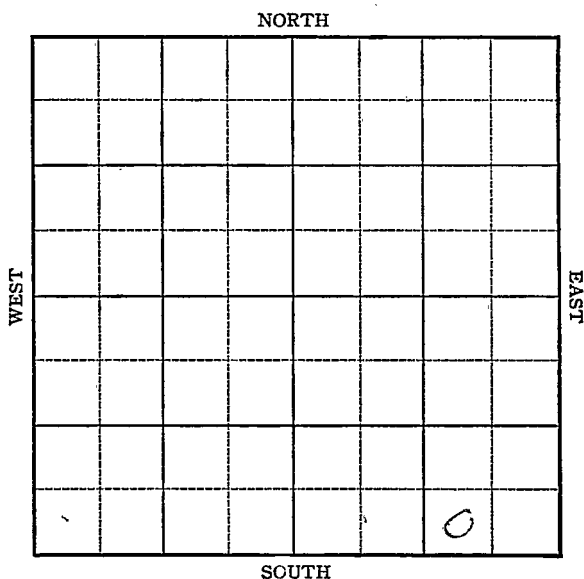

KANSAS

Graham County

Sec. 22 Twp. 8 R. 21W

Well No. #1 Mewere 24 Strat Farm

Continental Company


Wildcat

 Ft. from N. Line

330 Ft. from S. Line

990 Ft. from E. Line

 Ft. from W. Line

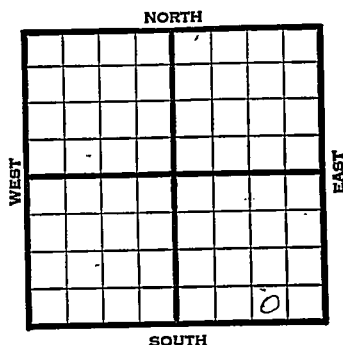

SW SE SE

1945

REPORT
Elev. 2024 Gr.

5/2

Topeka	3012
Lans	3365
SSO	3430-3435
Cong	3580
Arb	3665
TD	3684

FIRST REPORT

&

ABANDONED

3665
2024
16 41

Kansas Pool Name WildcatMap No. 65 Sec. 22 Twp. 8 R. 21WWell No. 1 Mewere 24 StratContinental Company

FIRST REPORT

and

Contractor

ABANDONED E. 12024 G.


SW SE SE

SECTION PLAT

Ft. from N. Line

330 Ft. from S. Line990 Ft. from E. Line

Ft. from W. Line

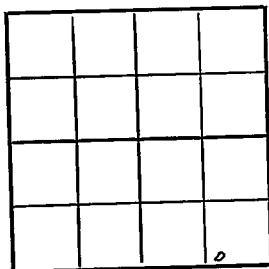Graham County

Location

Rig up

Drilling and Remarks:

Topeka 3012

Lens 3365

SSO 3430-35

Cong 3580

Arb 3665

D & A

RECORD

Cased _____ in., _____ ft.

Sand _____

Gas _____

Oil _____

Total Depth 3684

PRODUCTION

1st 24 hrs. Nat. _____

1st 24 hrs. after shot _____

Gas _____ Cu. Ft.

Dry Hole _____

Abandoned _____

Date

MAY 2 1945

19

S. J. LEWIS

Scout