


Section 23 Township 8 Range 19WWell No. #1 GreenCompany Keating Drlg.

NORTH

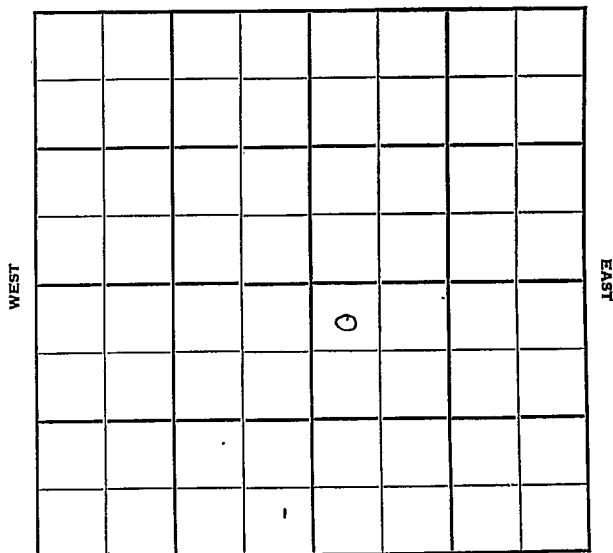

SOUTH

Hooks

KANSAS



Sec. 23 Twp. 8 R. 19 W

Well No. # 1 Green Farm

Keating Drlg. Company


Contractor

330 Ft. from N. Line

_____ Ft. from S. Line

_____ Ft. from E. Line

330 Ft. from W. Line

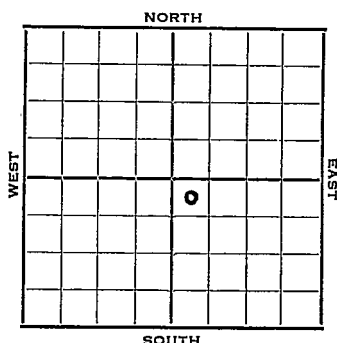

NW NW- SE

NCRA support

1952 Elev. 1962' REPORT

6/11 MIR
6/18 8" @ 193' Anhy 1370' Topeka 2907'
Drlg. 3030'
6/25 Spud 6-8-52
D&A TD 3460' 8" @ 193
Anhy 1370 Top. 2907
Heeb. 3115 Tor. 3137
Lans. 3155 SS0 3238-40
Cong. 3405 Arb. 3424
TD 3460 D&A


ABANDONED

County Rooks State KANSAS
 Sec. 23 (Blk.) 8 (Sur.) 19W Map No.

Operator Keating Drlg.

Well No. 1 Farm Green

Elev. Location NW NW SE

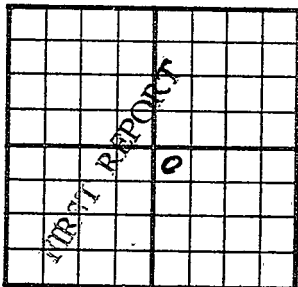

330 Ft. From N Line SE

330 Ft. From W Line Quarter

1st. Report JUN 11 1952

Completion

Remarks NCRA support

Spudding Date

Drlg. Data

M I R


J. G. McGEHEE

County _____ Rocks _____ State **Kansas**
 Sec. **23** (Blk. Twp.) **8** (Sur. Rge.) **19W** Map No. _____

Operator **Keating Drlg.**

Well No. **1** Farm **Green**

Elev. **1962** Location **NW NW SE**

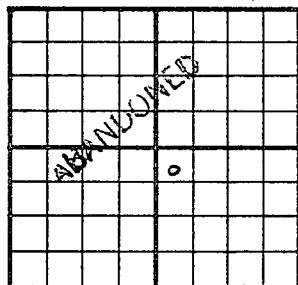

330 Ft. From **N** Line **SE**

330 Ft. From **W** Line **Quarter**

1st. Report _____

Completion **JUN 25 1952**

Remarks _____

Spudding Date **6-8-52**

Drlg. Data **D & A** **TD 3460**

8" @ 193 **Anhy 1370** **Top. 2907**

Heeb. 3115 **Tor. 3137** **Lans. 3155**

SSO 3238-40 **Cong. 3405** **Arb. 3424**

TD 3460

D & A

J. G. McGEHEE