


Section 23 Township 8 Range 19W

Well No. #1 Veverka

Company Musgrove & NCRA

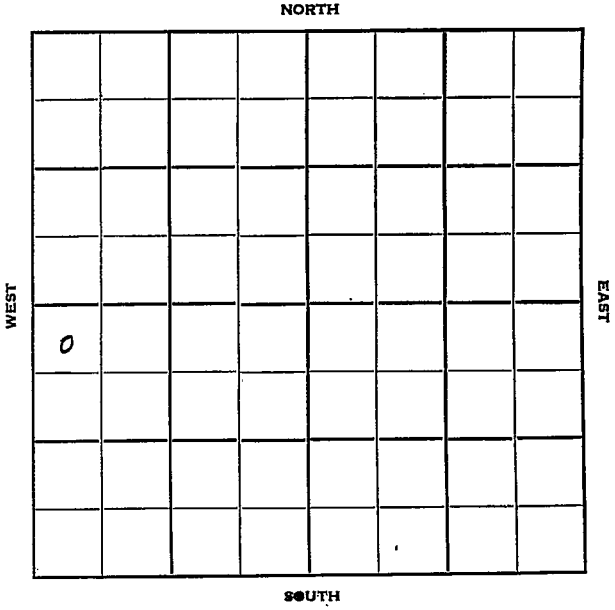

Rooks

KANSAS
19W

Sec. 23 Twp. 8 R. 19W

Well No. #1 Veverka Farm

Musgrove & NGRA Company

Contractor

Webster Pool


330' Ft. from N. Line

Ft. from S. Line

Ft. from E. Line

330' Ft. from W. Line

NW NW SW

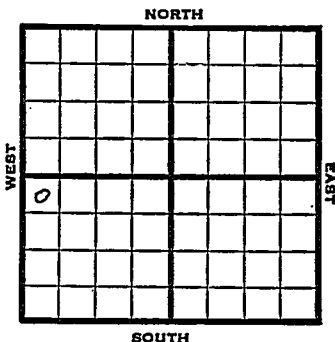

1951 Elev. 1915' REPORT

5/23 Cellar & Pits

6/20 Spud 5-27-51
D& A TD 3458
8" @ 207
Anhy 1355-1400 Top 2865
Heeb. 2979 Tor 3100
Lans. 3116
DST 3198-3215 opn 1½ hr
Rec. 60' mud & wtr
DST 3283-95 opn 1 hr Rec. 8'
socm
Cong. 3374 Arb. 3427
TD 3458'

D&A
ABANDONED

County Rooks State Kansas

Sec. 23 (Blk. Twp.) 8 (Sur. Rge.) 19W Map No.

Operator Musgrove & NCRA

Well No. 1 Farm Veverka

Elev. Location NW NW SW

FIRST REPORT					

330 Ft. From N Line SW

330 Ft. From W Line Quarter

1st. Report MAY 23 1951

Completion

Remarks

Spudding Date

Drlg. Data Webster Pool

Cellar & pits

J. E. TYRA

