Rooks County


FORM 51 10M 8-47

KANSAS

Section 23 Township 8 Range 18W

Well No. 1 ~~Rogers~~ Radke

Company Harry Gore etal

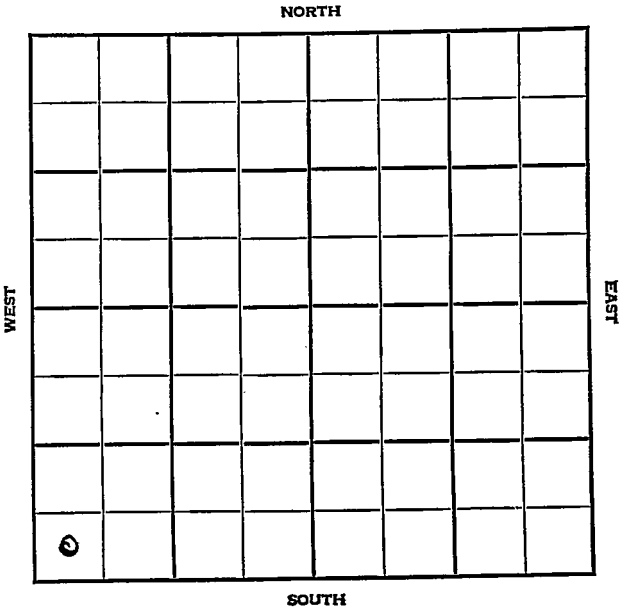

FORM 252-A
5M 9-47 PETROL

KANSAS Rooks ✓

Sec. 23 Twp. 8 R. 18W

Well No. #1 ~~Rogers~~ Radke Farm

Harry Gore et al Company

Wildcat


____ Ft. from N. Line

330 Ft. from S. Line

____ Ft. from E. Line

330 Ft. from W. Line

SW/C

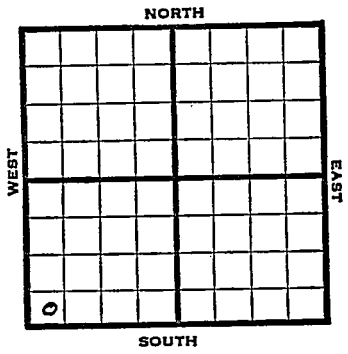

1947	Elev. 1986' REPORT
12/17	Location
12/30	8" @ 160' Drlg. 2360'
1948	
1/7	Lans. 3151' BKC 3400' Cong. 3435' Arb. 3481' Total Depth 3490' ABANDONED

Form 26 200 Bks. 10-46 Petrol

Kansas

Wildcat

Map No. _____ Sec. 23 Twp. 8 R. 18W


Well No. 1 Rogers

Harry Gore etal. Company

FIRST REPORT Contractor

SW/C

SECTION PLAT

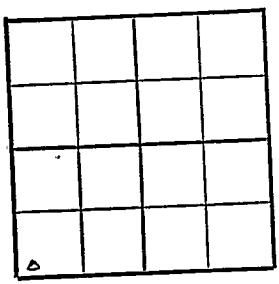

_____ Ft. from N. Line

330 Ft. from S. Line

_____ Ft. from E. Line

330 Ft. from W. Line

Rooks County

Location x

Rig up

Drilling and Remarks:

RECORD

Cased _____ in., _____ ft.

Sand

Gas

Oil

Total Depth

PRODUCTION

1st 24 hrs. Nat.

1st 24 hrs. after shot

Gas _____ Cu. Ft.

Dry Hole

Abandoned

Date

DEC 17 1947 19 S. J. LEWIS Scout

Wildcat

Form 26 200 Bks. 10-46 Petrol
Kansas

Map No. 64 Sec. 23 Twp. 8 R. 18W

Well No. 1 Radke


Harry Gore etal. Company

ABANDONED Contractor

E/1986

SW/C

SECTION PLAT

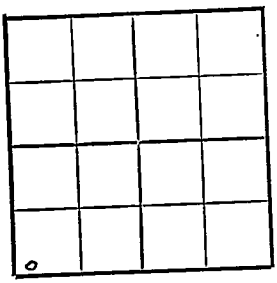

____ Ft. from N. Line

330 Ft. from S. Line

____ Ft. from E. Line

330 Ft. from W. Line

Rooks County

Location

Rig up

Drilling and Remarks:

Lans 3151
BKC 3400
Comp 3485
Ck 3487

RECORD

Cased ____ in., ____ ft.

Sand

Gas

Oil

Total Depth 3490

PRODUCTION

1st 24 hrs. Nat.

1st 24 hrs. after shot

Gas ____ Cu. Ft.

Dry Hole

Abandoned

Date

JAN 7 1948 19

S. J. LEWIS Scout

Form 26 200 Bks. 10-46 Petrol

Kansas

Wildcat

Map No. 64 Sec. 23 Twp. 8 R. 18W


Well No. 1 Radke

Harry Gore etal. Company

CORRECTION Contractor

SW/C

SECTION PLAT

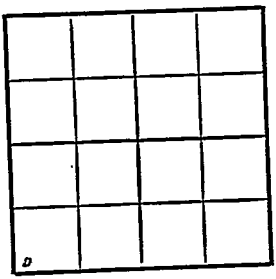

____ Ft. from N. Line

330 Ft. from S. Line

____ Ft. from E. Line

330 Ft. from W. Line

Rooks County

Location

Rig up

Drilling and Remarks:

Reported

#1 Rogers

RECORD

Cased ____ in., ____ ft.

Sand

Gas

Oil

Total Depth

PRODUCTION

1st 24 hrs. Nat.

1st 24 hrs. after shot

Gas ____ Cu. Ft.

Dry Hole

Abandoned

Date

DEC 2 3 1947 19

S. J. LEWIS Scout