

KANSAS


FORM 51 5M 10-41 PETROL

Sheridan

Section 23 Township 8 Range 26-W

Well No. #1 Pratt

Company Union Oil of California
Wildcat

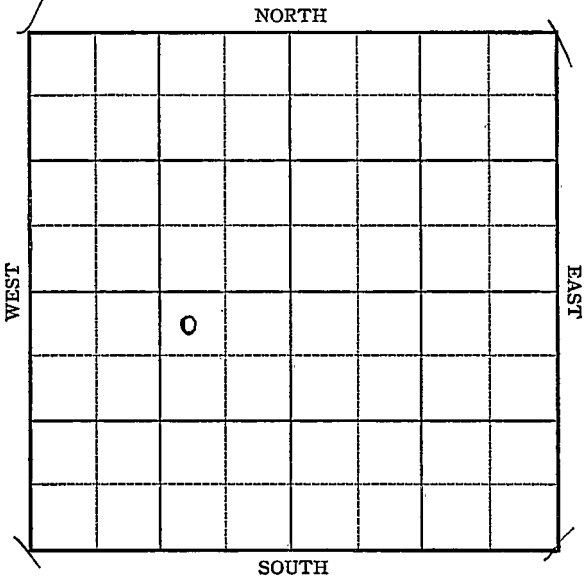

4515
2670
1845

myhane

KANSAS


Sheridan

Sec. 23 Twp. 8 R. 26-WWell No. #1 Pratt FarmUnion Oil of California Company

Wildcat

330 Ft. from N. Line Ft. from S. Line990 Ft. from E. Line Ft. from W. Line

Elev. 2510

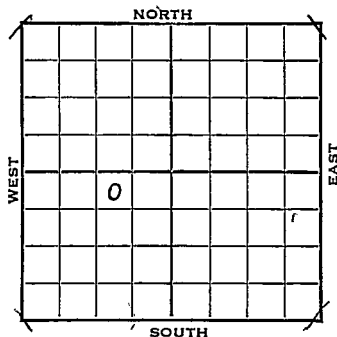

1942

REPORT

12/2 Loc.

12/9 "

12/16 "

12/22 "

12/29 Rotary

1943

1/6 "

1/13 "

1/20 100' SD.

1/27 Drlg. 2250'

2/3 13" casing set 255'

10" casing set 2055'

Anhy 2162

Topeka 3535 Heepner 36.95 (Gulf)

Lans 3679

SSO 3710-16, 3725-29,

Drlg. 3758'

2/10 SO 3756-58, 3806-12, and 3860-63

BKC 3903

Drlg. 4213'

~~SYSTEM~~ OVER

1943

4315
2510
1805

2/17 Miss 4202
B. Miss 4303
Arb ~~4313~~ 4315
TD 444
No show

2/24 5" Casing set 3899 to perforate
Lansing.

3/3 " " " " "

3/8 Top Lansing 3679
Showed porosity in Lansing
Top Arbuckle 4315
T.D. 4442
5" - 3899
Perforated 10 shots 3803-17
Filled up 2600 feet oil in 40 minutes
Waiting on tanks to test (Tel).

Running 115' higher on Kansas City Lansing
than Aladdin et al #1 Federal Land Bank in the
SW Corner 22-8S-25W (Dry hole)

Running 151' lower on Kansas City Lansing
than Flow et al #1 Davis in the SE SW SW of
27-7S-26W (Dry hole)

3/10 Swabbed 60 oil per hour - 3 hrs
41.1 Gravity (Telegram)

3/17 SD for tanks

3/24 "

4/7 "

4/14 "

4/21 "

4/24 Pumping potential 1378 (Telegram)

4/28 Lans 3679
5" @ 3899
T.D. 4444
P.B. 3877

Perf. Lans. Pump Pot. 689
State would not allow 1378 Pot.
Gravity 41

COMPLETED

Sheridan

KANSAS 7

Map No. 7 Sec. 23 Twp. 8 R. 26W

Well No. 1 Pratt

Union Oil of California Company

FIRST REPORT

Contractor

NW NE SW


SECTION PLAT

330 Ft. from N. Line

Ft. from S. Line

990 Ft. from E. Line

Ft. from W. Line

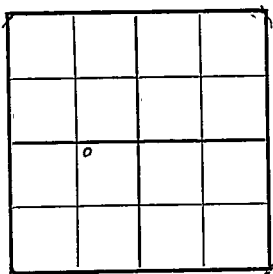

WILDCAT

Location XXX

Rig up

Drilling and Remarks:

RECORD

Cased in. ft.

Sand

Gas

Oil

Total Depth

PRODUCTION

1st 24 hrs. Nat.

1st 24 hrs. after shot

Gas Cu. Ft.

Dry Hole

Abandoned

Date

DEC 2 1942 19

S. I. LEWIS Scout

Sheridan

KANSAS

Map No. 67 Sec. 23 Twp. 8 R. 26WWell No. 1 Pratt

Union Oil of California Company

COMPLETED

Contractor

NW NE SW

SECTION PLAT

330 Ft. from N. Line

Ft. from S. Line

990 Ft. from E. Line

Ft. from W. Line

STUDLEY POOL

	6		

RECORD

Location

Cased _____ in., _____ ft.

Rig up

Sand _____

Drilling and Remarks:

Gas _____

Oil _____

Total Depth 4444

PRODUCTION

1st 24 hrs. Nat. _____

1st 24 hrs. after shot _____

Gas _____ Cu. Ft.

Dry Hole _____

Abandoned _____

Lease 36795" C3899PA 3897 Pely. LanePump Port 689State would notallow 1378 P & Y412 Gr

Date

APR 28 1943 19

S. J. LEWIS. Scout