

KANSAS

Section 23 Township 8 Range 21WWell No. #1 FerlandCompany Glickman Oil

NORTH

WEST

EAST

			0				

SOUTH

Graham

KANSAS

Sec. 23 Twp. 8 R. 21W

Well No. #1 Ferland Farm

Glickman Oil Company

Veeder - Contr. Contractor

Wildcat


330' Ft. from N. Line

..... Ft. from S. Line

330' Ft. from E. Line

..... Ft. from W. Line

NE NE SW

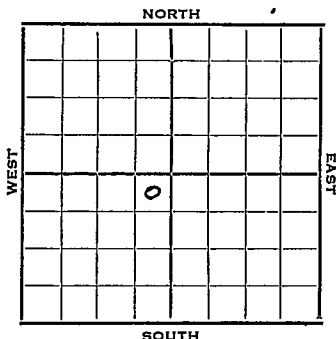

1951 Elev. 2066' REPORT

11/28 Spud 11-26-51

12/12 Spud 11-26-51

D&A TD 3669

8" @ 220

Anhy 1582 Heeb. 3265

KC 3304

DST 3334-48 open 1 hr. rec. 215' SW

DST 3371-91 open 1 hr. rec. 120' O&GCM

60' mud & wtr. 60' wtr. & GCM

120 SW

DST 3569-76 open $\frac{1}{2}$ hr. Rec. 12'


mud

Cong. 3570 Arb. 3616-69 TD

D&A

ABANDONED

County Graham State Kansas
 Sec. 23 (Blk.) 8 (Sur.) 21W Map No. _____
 Operator Glickman Oil
 Well No. 1 Farm Ferland
 Elev. _____ Location NE NE SW

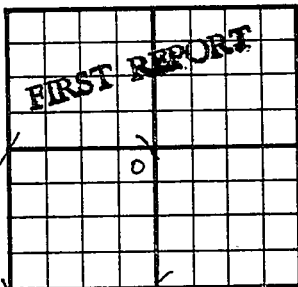

330 Ft. From N Line SW
330 Ft. From E Line Quarter
 1st. Report NOV 28 1951

Completion _____

Remarks _____


Veeder - Contr.

Spudding Date 11-26-51

Drlg. Data Wildcat

J. E. TYRA

County Graham State Kansas
 Sec. 23 (Blk. 8) (Sur. 21W) Map No. 21W
 Operator Glickman Oil
 Well No. 1 Farm Ferland
 Elev. 2066 Location NE NE SW

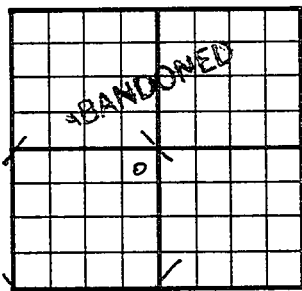

330 Ft. From N Line SW
330 Ft. From E Line Quarter
 1st. Report
 Completion DEC 1 2 1951
 Remarks Wildcat
Veeder - Contr.
 Spudding Date 11-26-51

Drlg. Data D & A TD 3669
8" @ 220 Anhy 1582 Heeb. 3265
KC 3304 DST 3334-48 open 1 hr.
Rec. 215' sw DST 3371-91 open 1 hr.
Rec. 120' o & gcm 60' mud & water
60' water & gcm 120' sw DST 3569-76
open $\frac{1}{2}$ hr. Rec. 12' mud Cong. 3570
Arb. 3616-69 TD

D & A

J. E. TYRA