

STATE CORPORATION COMMISSION OF KANSAS
OIL & GAS CONSERVATION DIVISION

WELL COMPLETION OR RECOMPLETION FORM
ACO-1 WELL HISTORY

DESCRIPTION OF WELL AND LEASE

Operator: License # 5131
Name Thunderbird Drilling, Inc.
Address P.O. Box 18407
City/State/Zip Wichita, KS 67218

Purchaser

Operator Contact Person Burke Krueger
Phone (316) 685-1441

Contractor: License # 5131
Name Thunderbird Drilling, Inc.

Wellsite Geologist Mark Thompson
Phone (316) 267-6153

Designate Type of Completion

- New Well Re-Entry Workover
- Oil SWD Temp Abd
- Gas Inj Delayed Comp.
- Dry Other (Core, Water Supply etc.)

If OWWO: old well info as follows:

Operator
Well Name
Comp. Date Old Total Depth

WELL HISTORY

Drilling Method:

- Mud Rotary Air Rotary Cable

8/1/85 8/6/85 8/6/85
Spud Date Date Reached TD Completion Date
3980
Total Depth PBDT

Amount of Surface Pipe Set and Cemented at 237' feet
Multiple Stage Cementing Collar Used? Yes No
If yes, show depth set feet
if alternate 2 completion, cement circulated from 0 feet depth to 237' w/ 170SX cmt

API NO. 15-065-22,165
County Graham
NE NE SW Sec. 35 Twp. 8S Rge. 24W East West

2310 Ft North from Southeast Corner of Section
2970 Ft West from Southeast Corner of Section
(Note: Locate well in section plat below)

Lease Name KEITH Well # 1


Field Name WC

Producing Formation

Elevation: Ground 2405' KB 2410'

Section Plat

SEP 09 1985
State Geological Survey
WICHITA BRANCH

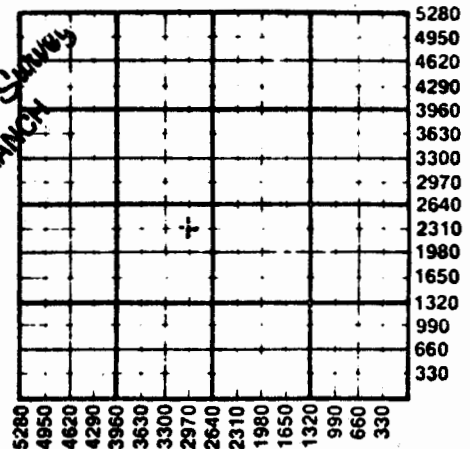

WATER SUPPLY INFORMATION

Disposition of Produced Water: Disposal Repressuring
Docket #

Questions on this portion of the ACO-1 call:

Water Resources Board (913) 296-3717

Source of Water:

Division of Water Resources Permit #

Groundwater Ft North from Southeast Corner (Well) Ft West from Southeast Corner of Sec Twp Rge East West

Surface Water Ft North from Southeast Corner (Stream, pond etc) Ft West from Southeast Corner Sec Twp Rge East West

Other (explain) Purchased from Oren Nickelson (purchased from city, R.W.D. #)

INSTRUCTIONS: This form shall be completed in duplicate and filed with the Kansas Corporation Commission, 200 Colorado Derby Building, Wichita, Kansas 67202, within 90 days after completion or recompletion of any well. Rule 82-3-130 and 82-3-107 apply.

Information on side two of this form will be held confidential for a period of 12 months if requested in writing and submitted with the form. See rule 82-3-107 for confidentiality in excess of 12 months.

One copy of all wireline logs and drillers time log shall be attached with this form. Submit CP-4 form with all plugged wells. Submit CP-111 form with all temporarily abandoned wells.

56228

SIDE TWO

Operator Name Thunderbird Drilling, Inc. Lease Name KEITH Well # 1

Sec. 35 Twp. 8S Rge. 24 East West County Graham

WELL LOG

INSTRUCTIONS: Show important tops and base of formations penetrated. Detail all cores. Report all drill stem tests giving interval tested, time tool open and closed, flowing and shut-in pressures, whether shut-in pressure reached static level, hydrostatic pressures, bottom hole temperature, fluid recovery, and flow rates if gas to surface during test. Attach extra sheet if more space is needed. Attach copy of log.

Drill Stem Tests Taken Yes No
Samples Sent to Geological Survey Yes No
Cores Taken Yes No

NO LOG

Formation Description
 Log Sample

Description	From	To
Surface Hole	0	237
Shale	237	1610
Sand	1610	1825
Shale	1825	2067
Anhydrite	2067	2106
Shale	2106	2245
Shale w/lime strks	2245	2530
Shale	2530	2825
Shale & Lime strks	2825	3065
Lime & Shale	3065	3260
Lime	3260	3660
Lime & Shale strks	3660	3792
Lime	3792	3980
R.T.D.	3980	

Name	Top	Bottom
Anhydrite	2067+	343
B/Anhydrite	2106+	304
Topeka	3493-	1083
Heebner	3708-	1298
LKC	3752-	1342
BKC	3971-	1561
RTD	3980-	1570

<p align="center">CASING RECORD <input type="checkbox"/> New <input type="checkbox"/> Used</p> <p align="center">Report all strings set-conductor, surface, intermediate, production, etc.</p>							
Purpose of String	Size Hole Drilled	Size Casing Set (in O.D.)	Weight Lbs/Ft.	Setting Depth	Type of Cement	#Sacks Used	Type and Percent Additives
Surface	12 1/4	8 5/8"	24#	237'	com	170	2% gel, 3% cc
PERFORATION RECORD				Acid, Fracture, Shot, Cement Squeeze Record			
Shots Per Foot	Specify Footage of Each Interval Perforated			(Amount and Kind of Material Used)			Depth
TUBING RECORD				Liner Run <input type="checkbox"/> Yes <input type="checkbox"/> No			
Date of First Production	Producing Method <input type="checkbox"/> Flowing <input type="checkbox"/> Pumping <input type="checkbox"/> Gas Lift <input type="checkbox"/> Other (explain).....						