
FORM 51 25M 3-49 PETROL Rooks KANSAS

Section 24 Township 8 Range 18W

Well No. #1 Pearl McMillen

Company Jones, Shelburne & Farmer

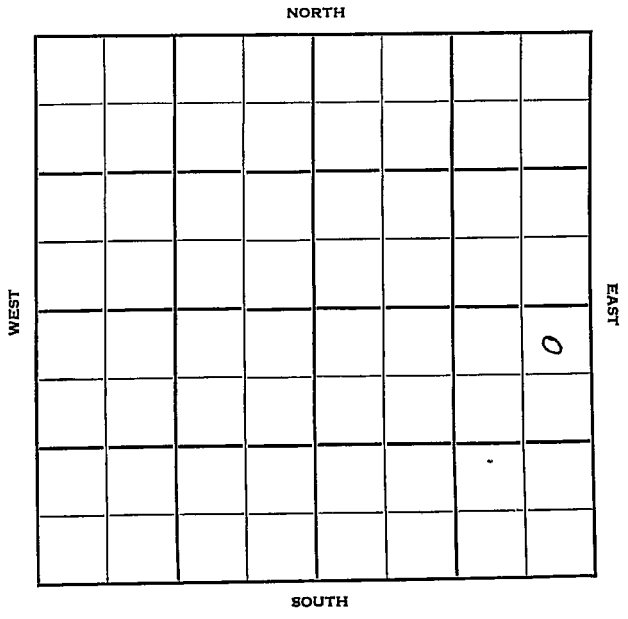

FORM 252-B
10M 8-51 TPCO. Rooks

KANSAS

Sec. 24 Twp. 8 R. 18W

Well No. #1 Pearl McMillen Farm

Jones, Shelburne & Farmer Company

Contractor

330 Ft. from N. Line


Ft. from S. Line

330 Ft. from E. Line

Ft. from W. Line

SE¼ NE NE SE

Stanolind Farmout

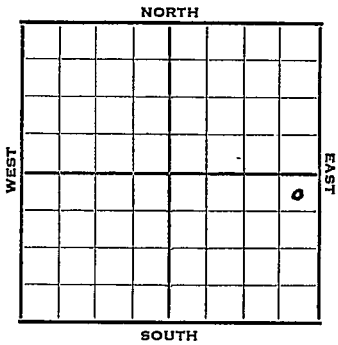

1952	Elev. 1994' REPORT
10/22	Spud 10-18-52 8"@ 159' Drlg. 1750'
10/29	Heeb 3117' Tor. 3137' Lans. 3157' DST 3305-16, 1/2 hr, 30' SOCM 1110# DST 3319-35, 20 mins, 180' SW 1170# Arb. 3415' RTD 3420' 5" @
11/5	5" @ 3420' DD 3427 TD 1000 A FU 1650' oil overnight
11/12	P/73 BO 77 hrs P/88 Bopd & trace wtr.
11/19	Spud 10-18-52 Oil well TD 3427' 8" @ 159 Heeb 3117' Tor. 3137' Lans. 3157' DST 3305-16 open ½ hr. rec 30' SOCM 1110# DST 3319-35 open 20 min, rec 180' SW 1170# Arb. 3415' TD 3420' 5" @ 3420 DD 3427 1000 A FU 1650' oil overnite. P/73 BO 17 hr. P/88 BOPD Comp. 85 BOPD 1½% wtr. COMPLETED

FORM 275 FOR SALE BY KANSAS BLUE PRINT CO.


County Rooks State Kansas

Sec. 24 (Blk. Twp.) 8 (Sur. Rge.) 18W Map No.

Operator Jones, Shelburne & Farmer

Well No. 1 Farm Pearl McMillen

Elev. Location NE NE SE

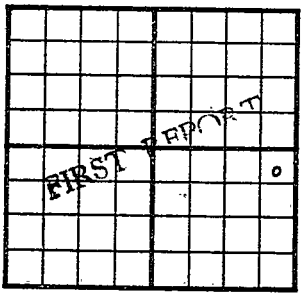

330 Ft. From N Line SE

330 Ft. From E Line Quarter

1st. Report OCT 22 1952

Completion

Remarks Stanolind farmout

Spudding Date 10-18-52

Drlg. Data

8" @ 159 drlg. 1750

J. G. McGEHEE

FORM 275 FOR SALE BY KANSAS BLUE PRINT CO.


County Rooks State Kansas

Sec. 24 (Blk. Twp.) 8 (Sur. Rge.) 18W Map No.

Operator Jones, Shelburne & Farmer

Well No. 1 Farm Pearl McMillen

Elev. 1994 Location NE NE SE

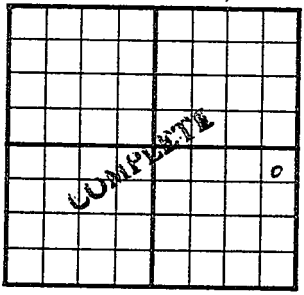

330 Ft. From N Line SE

330 Ft. From E Line Quarter

1st. Report

Completion NOV 1 0 1952

Remarks

Spudding Date 10-18-52

Drlg. Data Oil well TD 3427

8" @ 159 Heeb. 3117 Tor. 3137

Lans. 3157 DST 3305-16 open ½ hr.

Rec. 30' socm 1110# DST 3319-35

open 20 min. Rec. 180' sw 1170#

Arb. 3415 TD 3420 5" @ 3420 DD 3427

1000 A FU 1650' oil overnite

P/ 73 bo 17 hr. P/ 88 bopd

Comp. 85 bopd 1½% wtr.

J. G. McGEHEE