


Section 24 Township 8 Range 25WWell No. #1 EnglemanCompany Siegel

NORTH

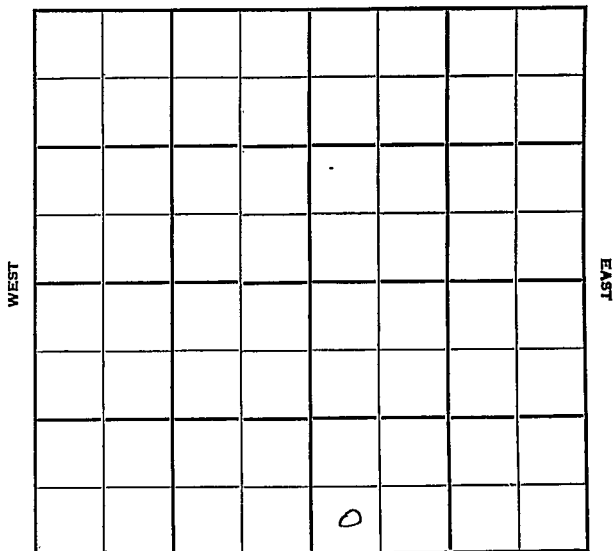

SOUTH

Graham

KANSAS

Sec. 24 Twp. 8 R. 25W

Well No. #1 Engleman Farm

Siegel

Company

Peel

Wildcat

Contractor

Ft. from N. Line

330


Ft. from S. Line

Ft. from E. Line

330

Ft. from W. Line

SW SW SE

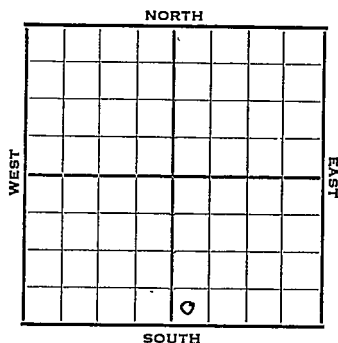

1952

Elev. 2338'

REPORT


4/9

Spud 4-6-52
8" @ 203' WOC

4/23

Spud 4-6-52
D&A TD 4250'
8" @ 203 Heeb. 3622 Tor. 3645
Lans. 3659 Marm. 3825
DST 3825-60 open $\frac{1}{2}$ hr. rec. 106' mud
Miss. 4177 TD 4250' D&A

ABANDONED

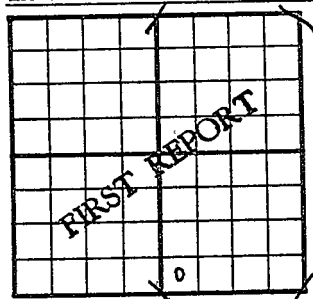
County Graham State KansasSec. 24 (Blk. Twp.) 8 (Sur. Rge.) 25W Map No.Operator SiegelWell No. 1 Farm EnglemanElev. Location SW SW SE330 Ft. From S Line SE330 Ft. From W Line Quarter1st. Report APR 9 1952

Completion

Remarks

Peel - Contr.Spudding Date 4-6-52Drlg. Data Wildcat8" @ 203 W.O.C.

J. G. MCGEHEE

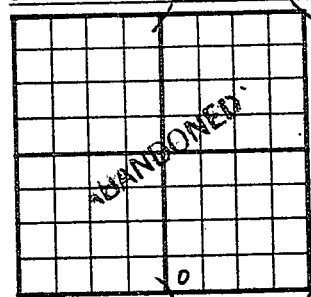County Graham State KansasSec. 24 (Blk.) 8 (Sur. Rge.) 25W Map No.Operator SiegelWell No. 1 Farm EnglemanElev. 2338 Location SW SW SE330 Ft. From S Line Se330 Ft. From W Line Quarter

1st. Report

Completion APR 23 1952Remarks WildcatPeel Drlg. - Contr.Spudding Date 4-6-52Drlg. Data D & A TD 42508" @ 203 Heeb. 3622 Tor. 3645Lans. 3659 Marm. 3825 DST 3825-60open $\frac{1}{2}$ hr. Rec. 106' mud Miss. 4177TD 4250D & A