



Sec. 24 Twp. 8 R. 19W

Well No. #1 M. Hamm Farm  
Empire Company


990' Ft. from N. Line

\_\_\_\_\_ Ft. from S. Line

\_\_\_\_\_ Ft. from E. Line

330' Ft. from W. Line

Elev. 1998

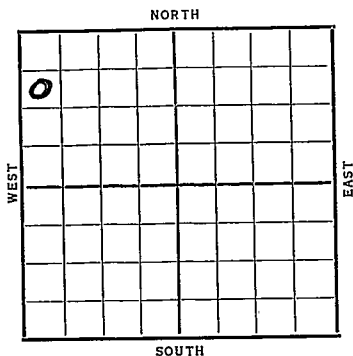

~~1936~~

REPORT

9/23	Rig.
10/1	Rig and tools.
10/8	Rigging up.
10/15	Drlg. 695'.
10/22	15" @ 760'. 12" @ 1114'. Drlg.
10/29	Anhydrate 1278'. 1280'. UR 12".
11/6	Drlg. 1990
11/12	Drlg. 2400'.
11/19	10" @ 2585'. Drlg.
11/27	Drlg. 2800'.
12/3	Fishing.
12/10	10" @ 2835'. Drlg. 3000'.
12/17	Oswald 3180' set 8".
12/29	Sil. 3575'. T. D. 3598'.
	H. F. W.

**ABANDONED**

Map No. 65 Sec. 24 Twp. J R. 19W

Well No. 1 M Ham

Empire Company

Contractor

## SECTION PLAT

990 Ft. from N. Line

\_\_\_\_\_ Ft. from S. Line

\_\_\_\_\_ Ft. from E. Line

330 Ft. from W. Line

0			

## FIRST REPORT

Location \_\_\_\_\_

Rig up \_\_\_\_\_

Drilling and Remarks:

*Rig*

## RECORD

Cased \_\_\_\_\_ in., \_\_\_\_\_ ft.

Sand \_\_\_\_\_

Gas \_\_\_\_\_

Oil \_\_\_\_\_

Total Depth \_\_\_\_\_

## PRODUCTION

1st 24 hrs. Nat. \_\_\_\_\_

1st 24 hrs. after shot \_\_\_\_\_

Gas \_\_\_\_\_ Cu. Ft.

Dry Hole \_\_\_\_\_

Abandoned \_\_\_\_\_

Date

SEP 23 1936

19

S. J. LEWIS

Scout

Map No. 65 Sec. 24 Twp. 8 R. 19W

Well No. 1 M. Nam

Empire Company

Contractor

**SECTION PLAT**

0			

990 Ft. from N. Line

\_\_\_\_\_ Ft. from S. Line

\_\_\_\_\_ Ft. from E. Line

330 Ft. from W. Line

**ABANDONED**

Location \_\_\_\_\_

Rig up \_\_\_\_\_

Drilling and Remarks:

Oil 3575

HFW.

D&A

**RECORD**

Cased \_\_\_\_\_ in., \_\_\_\_\_ ft.

Sand \_\_\_\_\_

Gas \_\_\_\_\_

Oil \_\_\_\_\_

Total Depth 3575

**PRODUCTION**

1st 24 hrs. Nat. \_\_\_\_\_

1st 24 hrs. after shot \_\_\_\_\_

Gas \_\_\_\_\_ Cu. Ft.

Dry Hole \_\_\_\_\_

Abandoned \_\_\_\_\_

Date

DEC 29 1936 19

S. J. LEWIS Scout