

Rooks



DX 78-1

Section 25 Township 8 Range 18^W

Well No. #2 Hazen

Company V.D. Sidey

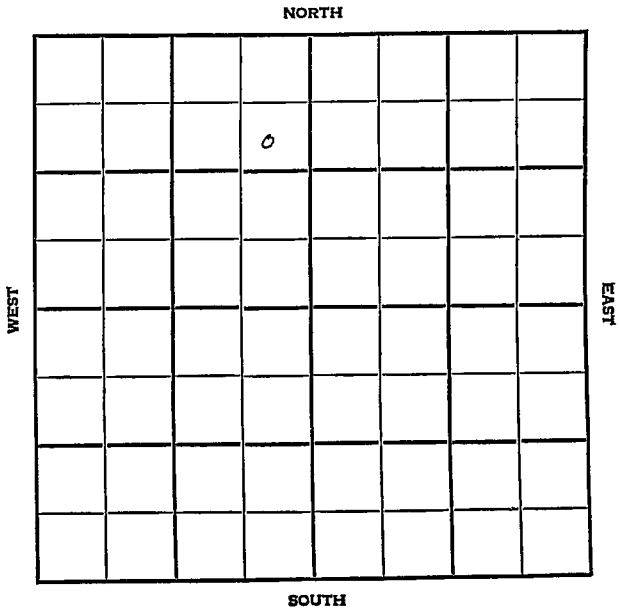

Rooks KANSAS

SEC. 25	TWP. 8	R. 18W
------------	-----------	-----------

WELL NO. 2 Hazen FARM

COMPANY V. D. Sidey

CONTRACTOR Sidey


Elm Creek Pool

990 Ft. from N. Line

Ft. from S. Line

330 Ft. from E. Line

Ft. from W. Line

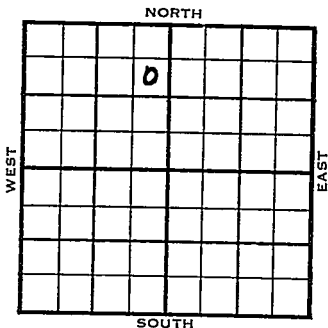

SE NE NW

1954	ELEVATION 1998'	REPORT
------	--------------------	--------

8-25

Spdg 8-19-54
8" @ 104
Drllg 2500

10/6

Spud 8-19-54 - Oil Well
TD 3420'
8" @ 104'
Arb. 3416'
TD 3420'
5" @ 3417'
CO to 3420' 1000A
Comp. 193 bopd

COMPLETED

County _____ Rooks _____ State Kansas

Sec. 25 (Blk. 8 (Sur. 18W (Twp. Map No. (Rge.)

Operator V. D. Sidey

Well No. 2 Farm Hazen

Elev. 1998 Location SE NE NW

		o			
COMPLETE					

990 Ft. From N Line NW

330 Ft. From E Line Quarter

Ist. Report

Completion OCT 6 1954

Remarks Elm Creek Pool

Sidey - Contr.

Spudding Date 8-19-54

Drlg. Data -Oil well TD 3420

8" @ 104 Arb. 3416 TD 3420 5" @ 3417

CO to 3420 1000 A Comp. 193 bopd

FABEN GILSTRAP