

Section 25 Township 8 Range 18 WWell No. # 1 McMillen "B"Company Cities Service

				0			

NORTH

WEST

EAST

SOUTH

Rooks

KANSAS

SEC.

TWP.

R.

25

8

18W

WELL NO.

#1 McMillen "B"

FARM

COMPANY

Cities Service

CONTRACTOR


330 Ft. from N. Line

Ft. from S. Line

Ft. from E. Line

330 Ft. from W. Line

NW NW NE

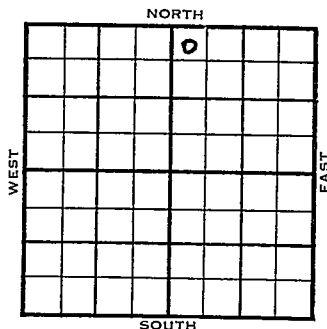

1953

ELEVATION

2006'

REPORT

9/9

9/16

Location

8" @ 235' Lans 3161'

DST 3162'-82', 1 hr, 40' O & GCM
600#

DST 3205'-26', 1 hr, 5' M

Drlg. 3226'

NR

NR

11/11

11/18

11/24

Spud 9-8-53

Oil Well

TD 3427'

8" @ 235'

Heeb 3120', Dodge 3142, Lans 3161.

DST 3162'-82' opn 1 hr, rec 40' o &
gcm 600#

DST 3205'-26' opn 1 hr, rec 5' Mud

DST 3308'-37' opn 1 hr, rec 37' socm
700#

B KC 3372, Arb 3420

TD 4322'

5" @ 3421'

DD 3427

14 goph 1000 A S/.91 bo 6 bw 11 hr.

P/ 139 bo 11 hr.

Comp 1271 bopd.

COMB

County Rooks State KansasSec. 25 (Blk.) 8 (Sur.) 18W Map No.Operator Cities ServiceWell No. 1 Farm McMillen "B"Elev. Location NW NW NE

330 Ft. From N Line NE330 Ft. From W Line Quarter1st. Report SEP 9 1953

Completion

Remarks

Spudding Date

Drlg. Data

Location

J. G. McGEHEE

County _____ Rocks _____ State KansasSec. 25 (Blk. Twp.) 8 (Sur. Rge.) 18W Map No. _____Operator Cities ServiceWell No. 1 Farm McMillen "B"Elev. 2006 Location NW NW NE

330 Ft. From N Line NE330 Ft. From W Line Quarter1st. ReportCompletion NOV 24 1953RemarksSpudding Date 9-8-53Drig. Data Oil well TD 34278" @ 235 Heeb. 3120 Dodge 3142Lans. 3161 DST 3162-82 open 1 hr.Rec. 40' o & gcm 600# DST 3205-26open 1 hr. Rec. 5' mud DST 3308-37open 1 hr. Rec. 37' socm 700#B KC 3372 Arb. 3420 TD 43225" @ 3421 DD 3427 14 goph 1000 AS/ 91 bo 6 bw 11 hr. P/ 139 bo 11 hr.Comp. 271 bopd

J. G. McGEHEE