

Graham

KANSAS

SECTION 25 TOWNSHIP 8S RANGE 25W

WELL NO. #1 Schamberger


COMPANY Empire Drlg. C S/2 NE NW

NORTH

~~SE NE NW~~

WEST

EAST

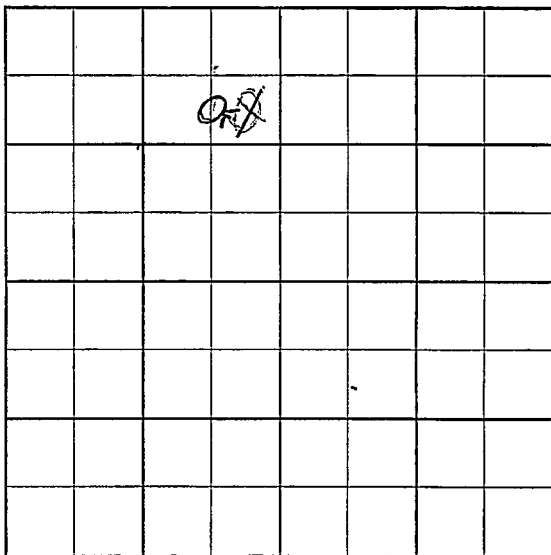

SOUTH

3

5

S-513-B

County Graham Elev. _____
Sec. 25 Twp. 8 Rge. 25W
Company Empire Drlg.
Farm Name Schamberger No. 1

TOPS	DEPTH	LOG	DATUM
Anh.			
Tp.			
H.			
Tr.			
Dg.			
B.L.			
L.			
K.C.			
B.K.C.			
Ce.			
C.			
M.			
M.			
K.			
Mz.			
Mq.			
V.			
S.			
S.			
A.			
R.			
Pf.			
G.			
T.D.			

Loc. in Sec. SE NE NW


Geol. _____

Contr. _____

Co. Tools # 1

Pool _____

Holley NW

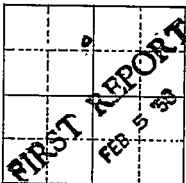

Date Comm. _____

WORT

Co.

Lse.

No.

Sec.

T.

R.

CORRECTION

5

S-513-B

County Graham Elev. 2622
 Sec. 25 Twp. 8 Rge. 25W 2389
 Company Empire Drlg.
 Farm Name Schamberger No. 1

TOPS	DEPTH	LOG	DATUM
Anh.	2090		
Tr.			
H.	3662		
Tr.	3684		
Dg.			
B.L.			
L.	3702		
K.C.			
B.K.C.			
Ce.			
C.			
M.			
M.			
K.			
Mz.			
Mq.			
V.			
S.			
S.			
A.			
R.			
Pf.			
G.			
T.D.	3860		

Loc. in Sec. SE NE NW
Q 212 ME. ME.
 Geol. _____
 Contr. _____
 Co. Tools #1
 Pool Holley NW
 0
 FEB 19 58
 ABANDONED

Date Comm. 2-5-58

WORT FEB 12 58 8 153/115 3600
 FEB 19 58 NO TESTS NO LOG

DBA