


Rooks

KANSAS

SECTION 25 TOWNSHIP 8 RANGE 20 WWELL NO. #1 Miller "A" "D"COMPANY Jones, Shelburne & Farmer

NORTH

WEST

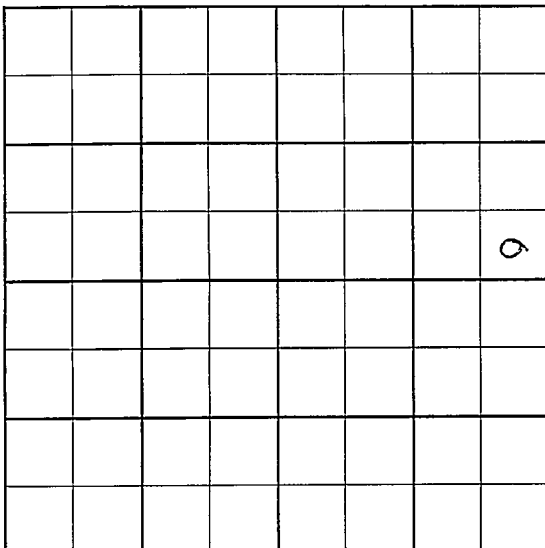

EAST

SOUTH

Rooks

KANSAS

SEC.	TWP.	R.
25	8	20W

WELL NO.

#1 Miller "A" "D"

FARM

COMPANY

Jones, Shelburne & Farmer

CONTRACTOR

Co. tools

WILDCAT


Ft. from N. Line

Ft. from S. Line

Ft. from E. Line

Ft. from W. Line

SE SE NE

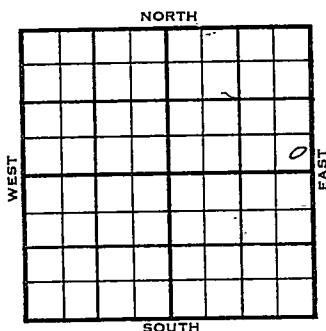

Sun- DHM

1955	ELEVATION 2061	REPORT
------	-------------------	--------

11-23 Cellar & pits

12-7 Comm. 11-23-55
 8 5/8" @ 171/125
 DST 3301-26 op 25 min. rec. 25' swm,
 1145#
 DST 3337-45 op 20 min. rec. 5' mud,
 1180#
 DST 3360-80 op 1 hr. rec. 145' sw,
 1175#
 DST 3415-27 op 1/2 hr. rec. 45' mud
 260/15"

D & A

TOPSDEPTHLOG

Anh.

1566

H.

3239

Tr.

####

3266

L.

3282

BKC

3490

C.

3522

A.

3534

TD 3563

ABANDONED

County Rocky Elev. 2061 Co.
 Sec. 25 Twp. 8 Rge. 20W
 Company Jones, Shelburne & Farmer
 Farm Name Miller "D" No. 1

TOPS	DEPTH	LOG	DATUM	Loc. in Sec.	
Anb.	1566			SE SE NE	
Tr.		3239	1178		
H.		3266	1205		
Dg.					
BL.					
L.		3282	1221	Geol.	
K.C.		3490	1429	Contr.	
B.K.C.		3522	1461	Co. tools	
Ce.				Pool	
C.				Wildcat	
M.					
M.					
K.					
Mz.					
Mq.					
V.					
S.					
S.		3534	1473		
A.					
R.					
Pe.					
G.					
TD.	3563				

Date Comm. 11-23-55 DEC 7 1955
8 5/8" @ 171/125 DST 3301-26 open
25 min. rec. 25' swm 1145#
DST 3337-15 open 20 min. rec. 5' mud
1180# DST 3360-80 open 1 hr. rec.
115' sw 1175# DST 3415-27 open 1/2 hr
rec. 115' mud 260/15"
D & A

ABANDONED