Sheriden Kansas

DX 78-1

Section 25 Township 8 Range 26W

Well No. 1 Fox

Company ~~Jones Chelburne & Farmer~~

NORTH

WEST

EAST

SOUTH

14

Sheridan KANSAS

SEC.	TWP.	R.
25	8	26W

WELL NO.

1 Fox FARM

COMPANY

Jones, Shelburne & Farmer

CONTRACTOR

J-S-F - Contr.

Wildcat

_____ Ft. from N. Line

330 Ft. from S. Line

330 Ft. from E. Line

_____ Ft. from W. Line

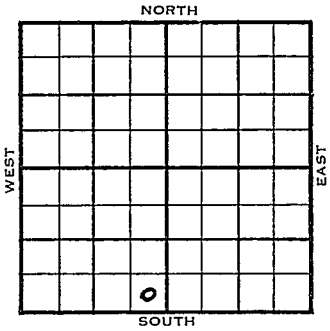

SE SE SW Sohio & NCRA-DHM

1954	ELEVATION 2535 REPORT
6/14	Spdg 6-10-54 8" @ 163 Anhy 2255 Drlg. 3155
6/23	Heeb 3689', Lans 3727' DST 3736-3810', 1 hr., 1590' SW, 160# DST 3878-3920', 1 hr., 65' M, 1360# Drlg. 4201'
6/30	Spudding 6-10-54 D&A TD 4432 8" @ 163 Anhy 2255 Heeb 3800 Lans. 3839 DST 3736-3810 open 1 hr. Rec. 1590 sw 1160# DST 3878-3920 open 1 hr. Rec. 65' mud 1360# BKC 4060 Miss. 4377 TD 4432 D&A

ABANDONED

DX-78

FORM 275 FOR SALE BY KANSAS BLUE PRINT CO.

County Sheridan State Kansas

Sec. 25 (Blk. Twp.) 8 (Sur. Rge.) 26W Map No.

Operator Jones, Shelburne & Farmer

Well No. 1 Farm Fox

Elev. Location SE SE SW

FIRST REPORT

0

330 Ft. From S Line SW

330 Ft. From E Line Quarter

1st. Report JUN 15 1954

Completion

Remarks Sohio & NCRA - DHM

J-S-F - Contr.

Spudding Date 6-10-54

Drlg. Data Wildcat

8" @ 163' Anhy 2255 drlg. 3155

J. G. McGEHEE

FORM 275 FOR SALE BY KANSAS BLUE PRINT CO.

County Sheridan State Kansas

Sec. 25 (Blk. Twp.) 8 (Sur. Rge.) 26W Map No.

Operator Jones, Shelburne & Farmer

Well No. 1 Farm Fox

Elev. 2535 Location SE SE SW

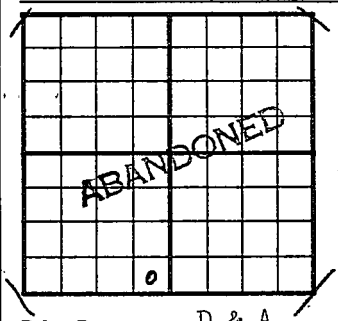

330 Ft. From S Line SW Quarter

330 Ft. From E Line

1st. Report

Completion JUN 30 1954

Remarks Wildcat

J-S*F - Contr.

Spudding Date 6-10-54

Drlg. Data D & A TD 4432

8" @ 163 Anhy 2255 Heeb. 3800

Lons. 3839 DST 3736-3810 open 1 hr.

Rec. 1590' sw 1160# DST 3878-3920

open 1 hr. Rec. 65' mud 1360#

B KC 4060 Miss. 4377 TD 4432

D & A

J. G. McGEHEE