

PT

State Geological Survey
WICHITA BRANCH

20-8-26 W

AFFIDAVIT AND COMPLETION FORM

ACQ-1

This form must be filed in triplicate with the Kansas Corporation Commission, 200 Colorado Derby Building, Wichita, Kansas 67202, within five days after the completion of the well, regardless of how the well was completed. Circle one: Oil, gas, dry SWD, OWWO, injection. Please type. Complete ALL sections. Applications must be filed for dual completion, commingling, salt water disposal and injection. Attach wireline logs (i.e. electrical log, sonic log, gamma ray neutron log, etc.) KCC#-(316) 263-3238.


OPERATOR Cross-Timbers Oil Co. API NO. 15-179-20,607
ADDRESS 212 N. Market, Suite 400 COUNTY Sheridan
Wichita, Kansas 67202 FIELD Overlook North
**CONTACT PERSON Bill Shepherd LEASE Taylor
PHONE 263-1008

PURCHASER _____ WELL NO. #1
ADDRESS _____ WELL LOCATION NE NE NW
330 Ft. from North Line and
330 Ft. from East of NE/4 Line of
the NW SEC. 20 TWP. 8S RGE. 26W

DRILLING CONTRACTOR Murfin Drilling Company
ADDRESS 617 Union Center
Wichita, Kansas 67202

PLUGGING CONTRACTOR Murfin Drilling Company
ADDRESS 617 Union Center

TOTAL DEPTH 3880 PBDT _____
SPUD DATE 7/17/81 DATE COMPLETED 7/24/81
ELEV: GR2464 DF 2466 KB 2469

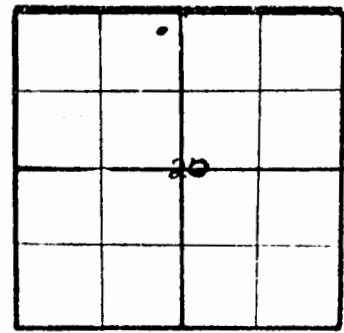

WELL PLAT
(Quarter) or (Full) Section - Please indicate.

Kes ✓

DRILLED WITH (CABLE) (ROTARY) (AIR) TOOLS
Report of all strings set— surface, intermediate, production, etc. (New)/(Used) casing.

Purpose of string	Size hole drilled	Size casing set (in O.D.)	Weight lbs/ft.	Setting depth	Type cement	Sucks	Type and percent additives
surface	12 1/4"	85/8"	24#	240'	common	180	

LINER RECORD				PERFORATION RECORD		
Top, ft.	Bottom, ft.	Sacks cement		Shots per ft	Size & type	Depth interval
TUBING RECORD						
Size	Setting depth	Packer set at				

ACID, FRACTURE, SHOT, CEMENT SQUEEZE RECORD

Amount and kind of material used _____ Depth interval treated _____

20-8-26W

Name of lowest fresh water producing stratum _____ Depth _____
 Estimated height of cement behind pipe _____

WELL LOG

Show all important zones of porosity and contents thereof; cored intervals, and all drill-stem tests, including depth interval tested, cushion used, time tool open, flowing and shut-in pressures, and recoveries

SHOW GEOLOGICAL MARKERS, LOGS RUN, OR OTHER DESCRIPTIVE INFORMATION.

FORMATION DESCRIPTION, CONTENTS, ETC.	TOP	BOTTOM	NAME	DEPTH
			Lansing/ Kansas City	3642 (-1173)
USE ADDITIONAL SHEETS, IF NECESSARY, TO COMPLETE WELL RECORD.				

A F F I D A V I T

STATE OF Kansas, COUNTY OF Sedgwick SS,

William Shepherd OF LAWFUL AGE, BEING FIRST DULY SWORN UPON HIS
 OATH, DEPOSES AND SAYS:

THAT HE IS Geologist FOR Cross-Timbers Oil Co.
 OPERATOR OF THE Taylor LEASE, AND IS DULY AUTHORIZED TO MAKE THIS
 AFFIDAVIT FOR AND ON BEHALF OF SAID OPERATOR. THAT WELL NO. 1 ON SAID LEASE HAS