

Judy P

TYPE

AFFIDAVIT OF COMPLETION FORM

ACO-1 WELL HISTORY

SIDE ONE

27-8-26 W Compt. _____

Two (2) copies of this form shall be filed with the Kansas Corporation Commission, 200 Colorado Derby Building, Wichita, Kansas 67202, within thirty (30) days after the completion of a well, regardless of how the well was completed.

F Attach separate letter of request if the information is to be held confidential. If confidential, only file one copy. Information on Side One will be of public record and Side Two will then be held confidential.

Applications must be made on dual completion, commingling, salt water disposal, injection and temporarily abandoned wells.

C Attach one copy only wireline logs (i.e. electrical log, sonic log, gamma ray neutron log, etc.). (Rules 82-2-105 & 82-2-125) KCC# (316) 263-3238.

LICENSE # 6114 EXPIRATION DATE 6-30-83

OPERATOR Don E. Pratt API NO. 15-179-20,665

ADDRESS P.O. Box 370 COUNTY Sheridan

Hays, KS 67601 FIELD _____

** CONTACT PERSON Don E. Pratt PROD. FORMATION LKC

PHONE 913-625-3446

PURCHASER _____ LEASE Robben

ADDRESS _____ WELL NO. 15-27

WELL LOCATION C NW/4

DRILLING CONTRACTOR Murfin Drilling Co., 1320 Ft. from S Line and

ADDRESS 617 Union Center 1320 Ft. from E Line of

Wichita, KS 67202 the NW (Qtr.) SEC 27 TWP 8 RGE 26 W

PLUGGING CONTRACTOR Murfin Drilling Co., WELL PLAT _____ (Office Use Only)

ADDRESS 617 Union Center KCC _____

Wichita, KS 67202 KGS

TOTAL DEPTH 3940 PBTD _____ SWD/REP _____

SPUD DATE 9/9/82 DATE COMPLETED 9/15/82 PLG. _____

ELEV: GR 2529 DF 2532 KB 2534

DRILLED WITH (CABLE) (ROTARY) (AIR) TOOLS.

DOCKET NO. OF DISPOSAL OR REPRESSURING WELL BEING USED TO DISPOSE OF WATER FROM THIS LEASE _____

Amount of surface pipe set and cemented 212' DV Tool Used? _____

THIS AFFIDAVIT APPLIES TO: (Circle ONE) - Oil, Gas, Shut-in Gas, (Dry) Disposal, Injection, Temporarily Abandoned, OWWO. Other _____

ALL REQUIREMENTS OF THE STATUTES, RULES AND REGULATIONS PROMULGATED TO REGULATE THE OIL AND GAS INDUSTRY HAVE BEEN FULLY COMPLIED WITH.


A F F I D A V I T

Don E. Pratt, being of lawful age, hereby certifies that:

I am the Affiant, and I am familiar with the contents of the foregoing Affidavit. The statements and allegations contained therein are true and correct.

Don E. Pratt
(Name)

State Geological Survey
WICHITA BRANCH

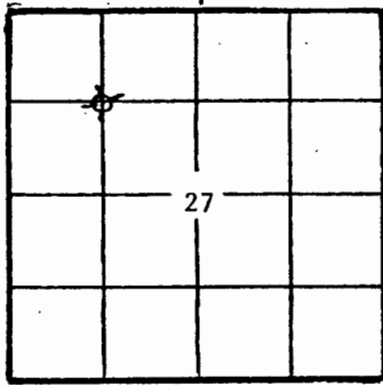

(Office Use Only)
KCC _____
KGS
SWD/REP _____
PLG. _____

OPERATOR Don E. Pratt

LEASE Robben

SEC. 27 TWP. 8S RGE. 26W

FILL IN WELL INFORMATION AS REQUIRED:

WELL NO. 15-27

Show all important zones of porosity and contents thereof; cored intervals, and all drill-stem tests, including depth interval tested, cushion used, time tool open, flowing and shut-in pressures, and recoveries.

SHOW GEOLOGICAL MARKERS, LOGS RUN, OR OTHER DESCRIPTIVE INFORMATION.

FORMATION DESCRIPTION, CONTENTS, ETC.	TOP	BOTTOM	NAME	DEPTH
Check if no Drill Stem Tests Run.				
Sand & Shale-----	212'			
Shale-----	1125'			
Sand & Shale-----	2151'			
Anhydrite-----	2183'			
Sand & shale-----	2700'			
Lime & shale-----	3040'			
Shale & Limestone-----	3225'			
Lime & Shale-----	3470'			
Shale & Limestone-----	3715'			
Lime & shale-----	3763'			
Shale & Limestone-----	3800'			
Lime & Shale-----	3870'			
Shale & Limestone-----	3878'			
Lime & Shale-----				

If additional space is needed use Page 2, Side 2

Report of all strings set — surface, intermediate, production, etc. CASING RECORD (New) or (Used)

Purpose of string	Size hole drilled	Size casing set (in O.D.)	Weight lbs/ft.	Setting depth	Type cement	Sacks	Type and percent additives
Surface	12 1/2"	8 5/8"	20#	212'	cgs	135	

LINER RECORD

PERFORATION RECORD

Top, ft.	Bottom, ft.	Sacks cement	Shots per ft.	Size & type	Depth interval

TUBING RECORD		
Size	Setting depth	Packer set at