

KANSAS


FORM 51 5M 6-46 PETROL

Mitchell county

Section 26 Township 8 Range 10-W

Well No. #1, Palen

Company Olson Drilling et al

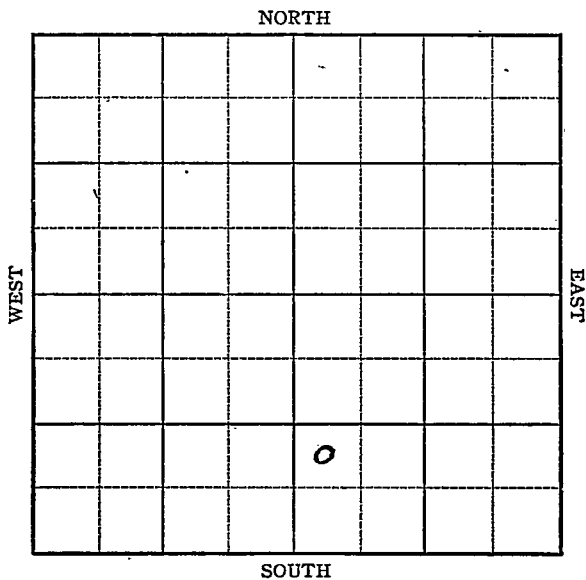

KANSAS

Mitchell ✓

Sec. 26 Twp. 8-S R. 10-W

Well No. #1 Palen Farm

Olson Drilling et al Company


Ft. from N. Line

990' Ft. from S. Line

Ft. from E. Line

330' Ft. from W. Line

NW SW SE

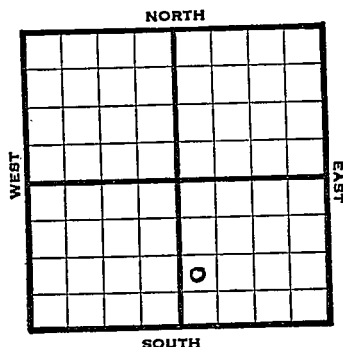

1946 Elev. 1825' REPORT

9/5 Location

9/10

"

9/18

"

9/24

"

10/1

"

10/8

"

10/15

"

10/22

"

10/29 Drlg 350'

11/6 Ft Riley 1605'

Drlg 2720'

11/12 Lang 3055

Miss 3599'

3610 fsg.

11/20

"

"

11/27

"

"

12/4 Viola 3840'

Simp. 4070'

Arb 4149'

TD 4205'

ABANDONED

KANSAS

Kansas

Pool Name WildcatMap No. 57 Sec. 26 Twp. .8 R. 10WWell No. 1 PalenOlson Drlg. etal.

Company

FIRST REPORT

Contractor

NW SW SE

SECTION PLAT

		o	

 Ft. from N. Line990 Ft. from S. Line Ft. from E. Line330 Ft. from W. LineMitchell CountyLocation XRig up

Drilling and Remarks:

RECORD

Cased in., ft.Sand Gas Oil Total Depth

PRODUCTION

1st 24 hrs. Nat. 1st 24 hrs. after shot Gas Cu. Ft.Dry Hole Abandoned

Date

SEP 5 1946 19

S. J. LEWIS

Scout


KANSAS

Wildcat

Form 26 200 Bks. 10-46 Petrol Kansas

Map No. 57 Sec. 26 Twp. 8 R. 10WWell No. 1 PalenOlson Drlg. etal. CompanyABANDONED Contractor

NW SW SE

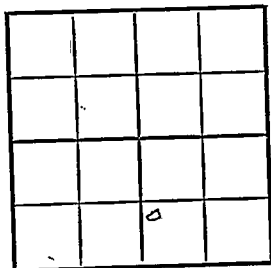E. 1825
SECTION PLAT Ft. from N. Line990 Ft. from S. Line Ft. from E. Line330 Ft. from W. LineMitchell CountyLocation Rig up

Drilling and Remarks:

Vista 3840Simp 4070Cor 4149

RECORD

Cased in., ft.Sand Gas Oil Total Depth 4205

PRODUCTION

1st 24 hrs. Nat. 1st 24 hrs. after shot Gas Cu. Ft.Dry Hole Abandoned

Date

DEC 4 1946 19 S. J. LEWIS Scout