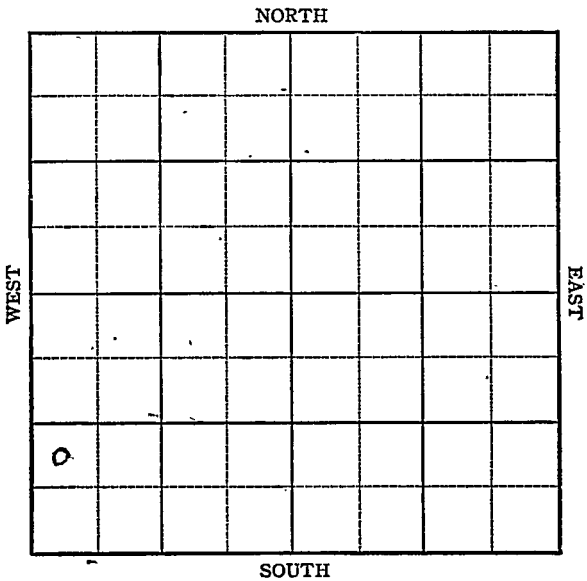


KANSAS

Rooks county

Section 26 Township 8 Range 19-WWell No. #1, F. Ververka "B"Company Shell Oil Company

Rooks County

Sec. 26 KANSAS Twp. 8 R. 19W

Well No. #1 F. Ververka "B" Farm

Shell


Ververka Company

 Ft. from N. Line

990 Ft. from S. Line

 Ft. from E. Line

330 Ft. from W. Line

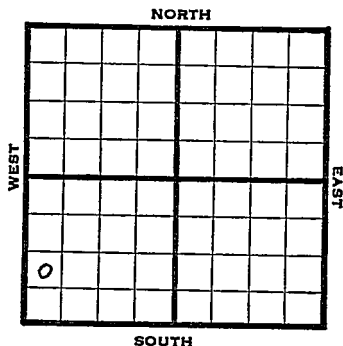

NW SW SW

1946 1972 REPORT

8/28	145'
9/5	13" @ 103'
	8" @ 1394'
	Drlg 2294'
9/10	Topeka 2911
	Lans 3140
	Drlg 3286'
9/18	Anhy 1398'
	Arb 3407'
	TD 3414
	4" @ 3408'
	1000 acid swb 66 W PH 2 hrs
9/24	" " "
10/2	Arb 3407'
	4" @ 3408'
	TD 3414'

ABANDONED

KANSAS Kansas Pool Name VerverkaMap No. 65 Sec. 26 Twp. 8 R. 19WWell No. 1 F. Ververka "B"

Shell


Company

FIRST REPORT

Contractor

NW SW SW

SECTION PLAT

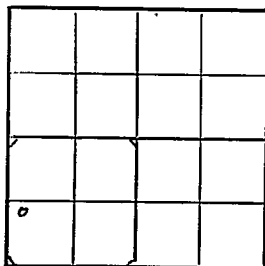

Ft. from N. Line

990 Ft. from S. Line

Ft. from E. Line

330 Ft. from W. Line

Rocks County

Location

Rig up

Drilling and Remarks:

145'

RECORD

Cased _____ in., _____ ft.

Sand _____

Gas _____

Oil _____

Total Depth _____

PRODUCTION

1st 24 hrs. Nat. _____

1st 24 hrs. after shot _____

Gas _____ Cu. Ft.

Dry Hole _____

Abandoned _____

Date

AUG 28 1946

S. J. LEWIS

Scout

KANSAS Kansas Pool Name Ververka PoolMap No. 63 Sec. 26 Twp. 8 R. 19WWell No. 1 F. Ververka "B"Shell

Company

ABANDONED

Contractor

NW SW SW

E/1972
SECTION PLAT

o			

Ft. from N. Line990 Ft. from S. LineFt. from E. Line330 Ft. from W. LineRooks County

Location

Rig up

Drilling and Remarks:

CR 8407# 108408.

RECORD

Cased _____ in., _____ ft.

Sand _____

Gas _____

Oil _____

Total Depth 2414

PRODUCTION

1st 24 hrs. Nat. _____

1st 24 hrs. after shot _____

Gas _____ Cu. Ft.

Dry Hole _____

Abandoned _____

Date

OCT 2 1946 19S. J. LEWIS

Scout