
FORM 51

Rooks KANSAS

Section 26 Township 8 Range 19W

Well No. #1 Verveka Est.

Company Jones, Shelburne & Farmer

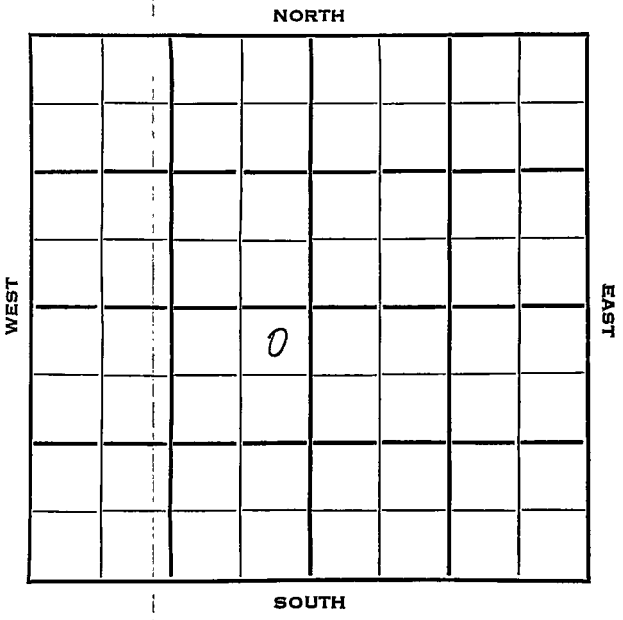

Rooks

FORM 252-B

KANSAS ✓

Sec. 26 Twp. 8 R. 19W

Well No. #1 Ververka Est. Farm

Jones , Shelburne & Farmer. Company

J-S-F Contractor

Wildcat.


330 Ft. from N. Line

_____ Ft. from S. Line

330 Ft. from E. Line

_____ Ft. from W. Line

NE NE SW

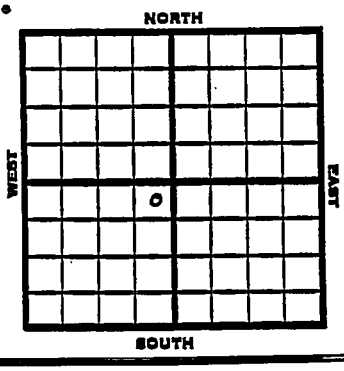

1953	Elev. 1974' REPORT
7/22	8" @ 150' Drlg 1380'.
7/29	Anhy 1390, Heeb 3129, Lans 3168 Drlg. 3285'
8/5	Spud 7-19-53 D&A TD 3548 8" @ 150 Anhy 1390, Heeb 3129, Lans 3168, Cong 3430 TD 3548 D&A

ABANDONED

FORM 275 FOR SALE BY KANSAS BLUE PRINT CO.


County Rooks State Kansas

Sec. 26 (Blk. Twp.) 8 (Sur. Rge.) 19W Map No.

Operator Jones, Shelburne & Farmer

Well No. 1 Farm Verveka Est.

Elev. Location NE NE SW

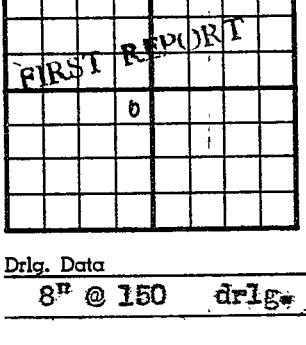

330 Ft. From N Line SW

330 Ft. From E Line Quarter

1st. Report JUL 22 1953

Completion

Remarks

J-S-F - Contr.

Spudding Date

Wildcat

Drlg. Data

8" @ 150 drlg. 1380

J. G. McGEHEE

FORM 275 FOR SALE BY KANSAS BLUE PRINT CO.


County Rooks State Kansas

Sec. 26 (Blk. Twp.) 8 (Sur. Rge.) 19W Map No.

Operator Jones, Shelburne & Farmer

Well No. 1 Farm Verveka Est.

Elev. 1974 Location NE NE SW

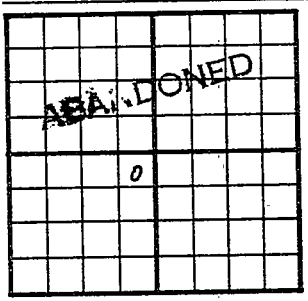

330 Ft. From N Line SW

330 Ft. From E Line Quarter

1st. Report

Completion AUG 5 1953

Remarks Wildcat

J-S-F - Contr.

Spudding Date 7-19-53

Drlg. Data D & A TD 3548

8" @ 150 Anhy 1390 Heeb. 3129

Lans. 3168 Cong. 3430 TD 3548

D & A

J. G. McGEHEE