


Section 26 Township 8 Range 26WWell No. #1 PrattCompany Jones, Shelburne & Farmer

NORTH

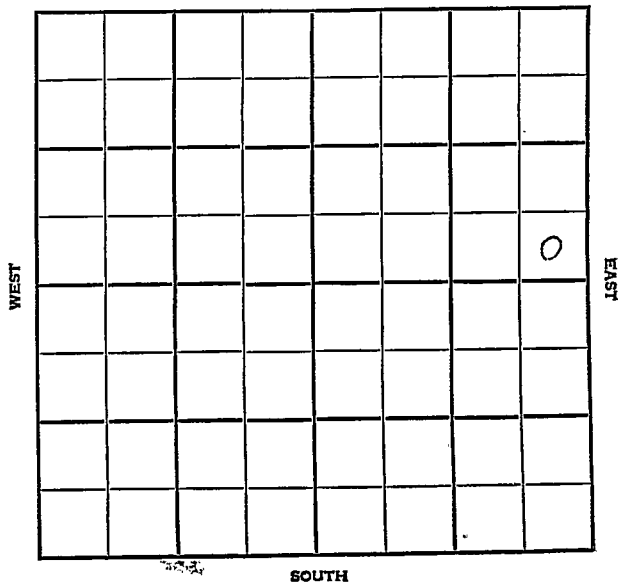

Sheridan

KANSAS

SEC.	TWP.	R.
26	8	26 W

WELL NO.

1 Pratt

FARM

COMPANY

Jones, Shelburne & Farmer

CONTRACTOR

Co. tools

Wildcat


_____ Ft. from N. Line

330 _____ Ft. from S. Line

330 _____ Ft. from E. Line

_____ Ft. from W. Line

SE SE NE

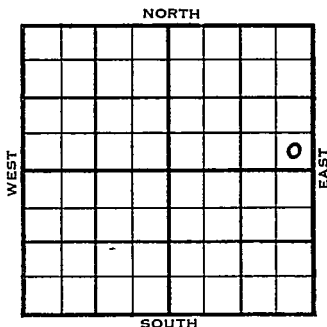

1955

ELEVATION

REPORT

3/23

Spud 3-12-55
Drlg. 2400'

FABEN GILSTRAP