


SECTION 26 TOWNSHIP 8S RANGE 27W

WELL NO. #2 Brown "A"

COMPANY Heathman

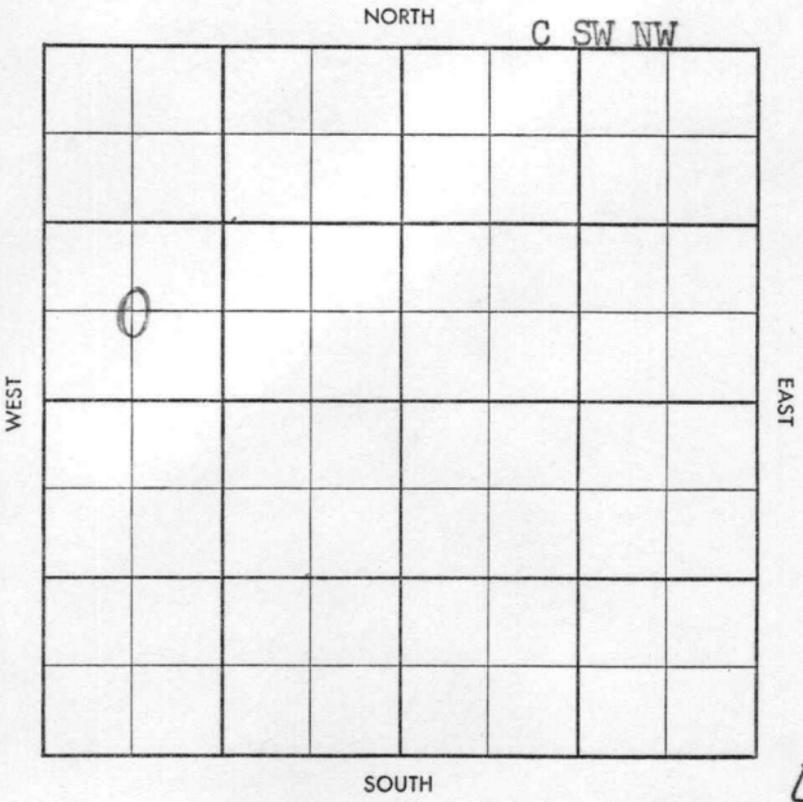

CO. Sheridan ELEV. 2597
 SEC. 26 TWP. 8 RGE. 27W
 COMPANY Heathman NO. 2

CO. _____
 FEB 12 '58
 0
ABANDONED

FARM Brown "A" Champlin - DHM
 LOC. C SW NW Carter - AC

A 2230
H 3728
TR 3753
L 3766
BKC 3992
Mar 4050
M 4352
TD 4385

GEOL. _____
 CONTR. B & B tools
 POOL Advance
 SPUD 1-22-58
 Location JAN 22 '58
 JAN 20 '58 8" 286/200
 Ø 3185 FEB 5 '58
 DST 3838-55
 60" 75' MW BAP
 1210/20 DST 3917
 -35 60" 25' M BHP 15 5/20"
 DST 3946-67 120" 25' M
 BHP 0 1/20" DST 4208-20
 60" 25' M BHP 35 1/20" Ø 4235
 FEB 12 '58 Van Log tops H 3726
 TR 3751 LIC 3764 BKC 3992
 Mar 4021 ~~D&A~~ Ce 4198
 MISS 4321 LTD 4385
 D & A

CO. _____
 LSE. _____
 NO. _____
 SEC. _____
 TWP. _____
 RGE. _____