



SIDE ONE

STATE CORPORATION COMMISSION OF KANSAS
OIL & GAS CONSERVATION DIVISIONWELL COMPLETION OR RECOMPLETION FORM
ACO-1 WELL HISTORY

DESCRIPTION OF WELL AND LEASE

Operator: license # 6033
 name Murfin Drilling Company
 address 250 North Water
 Suite 300
 City/State/Zip Wichita, Kansas 67202

Operator Contact Person L.O. Butner
 Phone 316-267-3241

Contractor: license # 6033
 name Murfin Drilling Company

Wellsite Geologist Jim Reeves
 Phone 913-674-5835

Designate Type of Completion

☒ New Well ☐ Re-Entry ☐ Workover

☒ Oil ☐ SWD ☐ Temp Abd
☐ Gas ☐ Inj ☐ Delayed Comp.
☐ Dry ☐ Other (Core, Water Supply etc.)

If ☐ NO: old well info as follows:

Operator
 Well Name
 Comp. Date Old Total Depth

WELL HISTORY

Drilling Method: ☒ Mud Rotary ☐ Air Rotary ☐ Cable
 5-21-85 5-28-85 6/19/85
 Spud Date Date Reached TD Completion Date
 4000' RTD 3959'
 Total Depth PBDT

Amount of Surface Pipe Set and Cemented at 179' feet

Multiple Stage Cementing Collar Used? ☒ Yes ☐ No

If Yes, Show Depth Set 2229' feet

If alternate 2 completion, cement circulated
 from 2229' feet depth to surf. w/ 425' SX cmt

API NO. 15-179-20,817

County Sheridan

NE SE SE Sec 14 Twp 8S Rge 27W
 (location)

990 Ft North from Southeast Corner of Section
 330 Ft West from Southeast Corner of Section
 (Note: locate well in section plat below)


Lease Name Taylor Well# 2-14

Field Name Pool Ext.

Producing Formation L/KC H & K Zones

Elevation: Ground 2559' KB 2564'

Section Plat

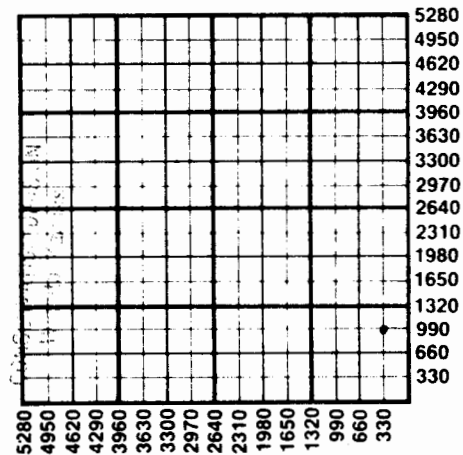

WATER SUPPLY INFORMATION

Source of Water:

Division of Water Resources Permit #

☐ Groundwater. Ft North From Southeast Corner and
 Ft. West From Southeast Corner of

Sec Twp Rge ☐ East ☐ West

☐ Surface Water. Ft North From Southeast Corner and
 (Stream, Pond etc.) Ft West From Southeast Corner

Sec Twp Rge ☐ East ☐ West

☐ Other (explain)
 (purchased from city, R.W.D.#)

Disposition of Produced Water:

☐ Disposal
☐ Repressuring

Docket #

INSTRUCTIONS: This form shall be completed in duplicate and filed with the Kansas Corporation Commission, 200 Colorado Derby Building, Wichita, Kansas 67202, within 90 days after completion or recompletion of any well. Rules 82-3-130 and 82-3-107 apply.

Information on side two of this form will be held confidential for a period of 12 months if requested in writing and submitted with the form. See rule 82-3-107 for confidentiality in excess of 12 months.

One copy of all wireline logs and drillers time log shall be attached with this form. Submit CP-4 form with all plugged wells. Submit CP-111 form with all temporarily abandoned wells.