


KANSAS Rooks County

FORM 51 5M 11-44 PETROL

Section 27 Township 8S Range 16W

Well No. #1 M. Himpler

Company @Sinclair Prairie

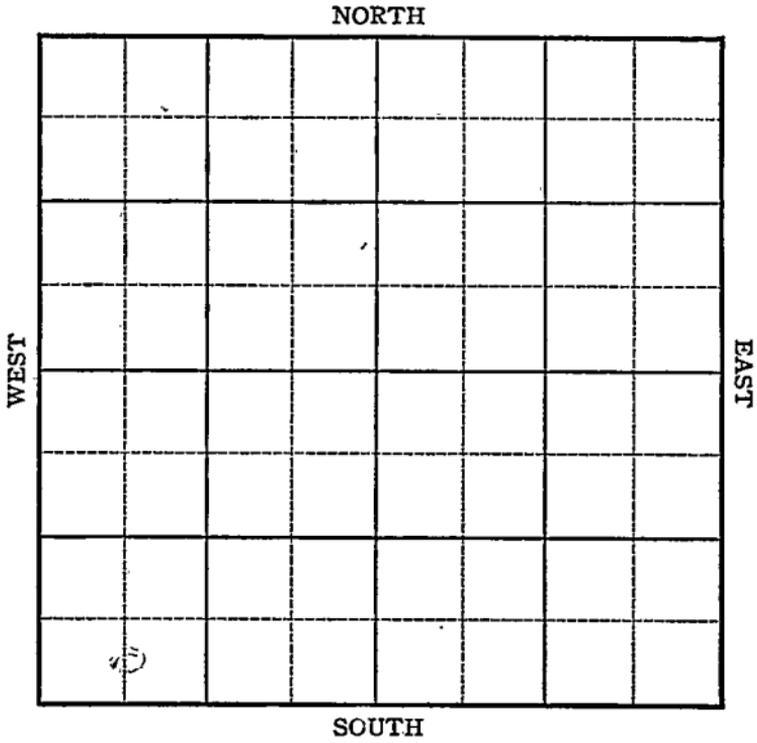

Sec. 27 Twp. 8 R. 16W

Well No. #1 M. Himpler Farm
Sinclair Prairie Company


Laton

_____ Ft. from N. Line

330 Ft. from S. Line

_____ Ft. from E. Line

660 Ft. from W. Line

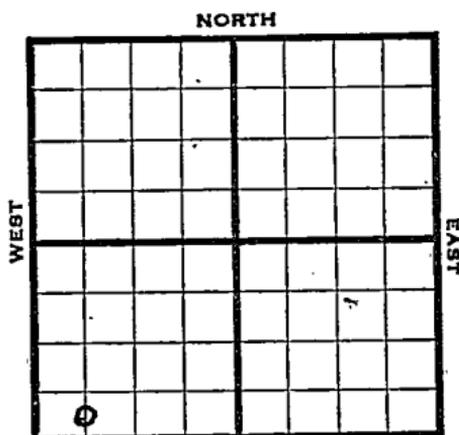

CSL SW SW *Elev. 1961*

1945

R E P O R T

3/21 Location
3/29 Surface Hole
4/5 10" @ 1250' WOC
4/12 Drlg. 2190'
4/21 Topeka. 2820
Lans 3075
TD 3119 SO
Run *esg.*
4/26 " " " "
5/3 " " " "
5/16 Lans 3075
5" @ 3119
TD 3121' 5000 acid.
Pump 84 Pot.
Grav. 31.0

COMPLETED

Pool Name Laton

Map No. 64 Sec. 27 Twp. 8 R. 16W

Well No. 1 M. Himpler

Sinclair Prairie Company

FIRST REPORT Contractor

C S L SW SW

SECTION PLAT

 Ft. from N. Line

330 Ft. from S. Line

 Ft. from E. Line

660 Ft. from W. Line

o			

Rooks County

RECORD

Location X

Cased in., ft.

Rig up

Sand

Drilling and Remarks:

Gas

Oil

Total Depth

PRODUCTION

1st 24 hrs. Nat.

1st 24 hrs. after shot

Gas Cu. Ft.

Dry Hole

Abandoned

Date

MAR 21 1945

19

S. J. LEWIS

Scout

Kansas Pool Name Laton

Map No. 64 Sec. 27 Twp. 8 R. 16W

Well No. 1 M. Hempler

Sinclair-Prairie Company

COMPLETED

Contractor

C S L SW SW

EI. 1961
SECTION FLAT

 Ft. from N. Line

330 Ft. from S. Line

 Ft. from E. Line

660 Ft. from W. Line

Rooks County

RECORD

Location

Cased in., ft.

Rig up

Sand

Drilling and Remarks:

Gas

4 ans 3075

Oil

5" 23119

Total Depth 3121

5000 acial

Pump 84 Pst

PRODUCTION

1st 24 hrs. Nat.

1st 24 hrs. after shot

Gas Cu. Ft.

Dry Hole

Abandoned

31° 30'

Date

MAY 16 1945 19

S. I. LEWIS Scout