


Section 27 Township 8 Range 19W

Well No. #1 Stice

Company V. D. Sidey

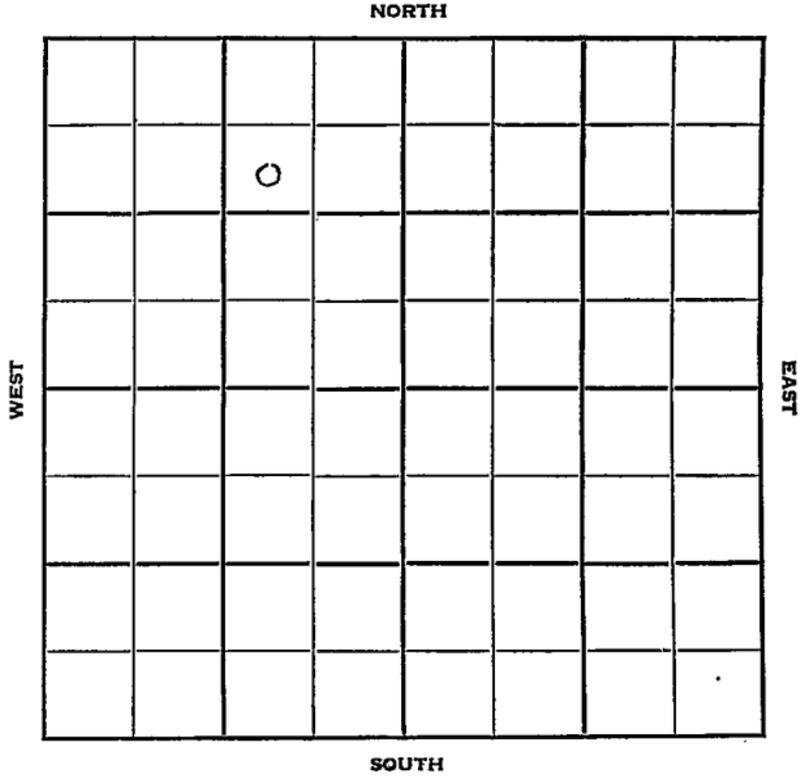

Rooks

KANSAS
19W

Sec. 27 Twp. 8 R.

Well No. #1 Stice Farm

V. D. Sidey Company

V. D. Sidey- Contr. Contractor


990' Ft. from N. Line

 Ft. from S. Line

990' Ft. from E. Line

 Ft. from W. Line

SW NE NW

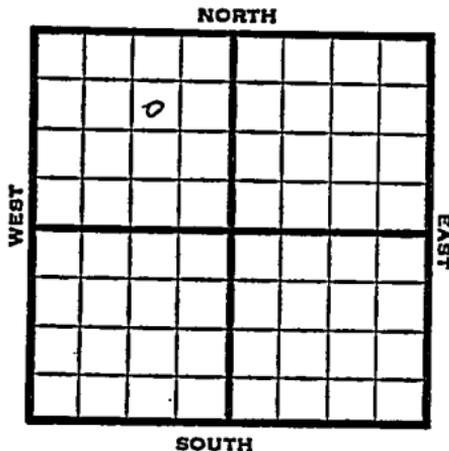

1951 Elev. 1988' REPORT

10/17 Spud 10-10-51
8" @ 129
Drlg. 2260'

1952
1/2 Spud 10-10-51
D&A TD 3430
8" @ 129
Top. 2930 Heeb. 3139
Lans. 3178 Arb. 3430-34
5" @ 3432 GO to 3430
D&A

ABANDONED


County Rooks State Kansas

Sec. 27 (Blk. Twp.) 8 (Sur. Rge.) 19W Map No.

Operator V. D. Sidey

Well No. 1 Farm Stice

Elev. 1988 Location SW NE NW

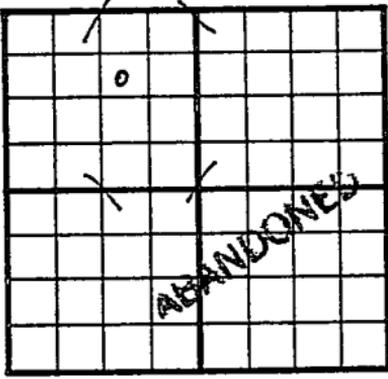

990 Ft. From N Line NW

990 Ft. From E Line Quarter

1st. Report

Completion JAN 2 1952

Remarks

Sidey - Contr.

Spudding Date 10-10-51

Drig. Data D & A TD 3430

8" @ 129 Top. 2930 Heeb. 3139

Lens. 3178 Arb. 3430-34 5" @ 3432

CO to 3430 D & A

J. E. TYRA