

Well No. 65 St Johns Farm
Big Coast Drly Company

WEST

LAST

SOUTH

15

Drilling Remarks

217^A

PRODUCTION

1st 24 hrs. Nat._____

1st 24 hrs. after shot _____

Gas _____ cu. ft. _____

Dry Hole_____

Abandoned_____


Braham
 Map No. **KANSAS** Sec. *27* Twp. *8* R. *25^W*
 Well No. *6 - St Johns* Farm
Buff Coast Wry Company

1570 Ft. from N. Line

_____ Ft. from S. Line

1360 Ft. from E. Line

1930 Ft. from W. Line

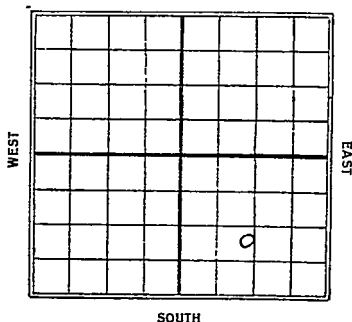

Date	REPORT
<i>5/7</i>	<i>Wry 2250' (Rotary)</i>
<i>5/14</i>	<i>" 2590'</i>
<i>5/21</i>	<i>No report</i>
<i>5/28</i>	<i>Wry 3012'</i>
<i>6/4</i>	<i>No report</i>
<i>6/11</i>	_____
<i>6/18</i>	_____
<i>6/25</i>	<i>8" 4360'</i>
	<i>Wry 4370'</i>
<i>7/2</i>	<i>Wry 4370'</i>
<i>7/9</i>	_____
<i>7/16</i>	_____
<i>7/23</i>	_____
<i>7/30</i>	<i>No report</i>
<i>8/6</i>	_____
<i>8/13</i>	<i>Wry 5200'</i>
<i>8/20</i>	<i>SLP 5200'</i>
<i>8/27</i>	_____
<i>9/3</i>	_____
<i>9/10</i>	_____
	(over)

9/17- HFW 4459-62
HFW 4510-18
HFW 4599-4624
TD 5037
Abandoned

Statham
KANSAS
 Map No. _____ Sec. 27 Twp. 8 R. 25W

Well No. 6 *Statham*
Gulf Coast Oil Co. Company

Contractor

SECTION PLAT

1570 Ft. from N. Line

_____ Ft. from S. Line

1360 Ft. from E. Line

_____ Ft. from W. Line

FIRST REPORTS

Location _____

Rig up _____

Drilling and Remarks: _____

Rotary

Dr 16 2250

RECORD

Cased _____ in., _____ ft.

Sand _____

Gas _____

Oil _____

Total Depth _____

PRODUCTION

1st 24 hrs. Nat. _____

1st 24 hrs. after shot _____

Gas _____ Cu. Ft.

Dry Hole _____

Abandoned _____

Date

MAY 7 1930

S. J. LEWIS Scout

Map No. **KANSAS** Sec. 27 Twp. 8 R. 25W

Well No. 6 *St. Johns*

Gulf Coast Oil Company

Contractor

SECTION PLAT

1570 Ft. from N. Line

..... Ft. from S. Line

1360 Ft. from E. Line

..... Ft. from W. Line

		0	

ABANDONED

Location

Rig up

Drilling and Remarks:

NFW 4459-62

NFW 4510-18

NFW 4599-4624

RECORD

Cased in., ft.

Sand

Gas

Oil

Total Depth 50.37

PRODUCTION

1st 24 hrs. Nat.

1st 24 hrs. after shot

Gas Cu. Ft.

Dry Hole

Abandoned

Date

SEP 17 1930

192

S. J. LEWIS Scout