Rooks


FORM 51 10M 8-47

KANSAS

Section 27 Township 8 Range 19 W

Well No. #4 Green "A"

Company W L Hartman

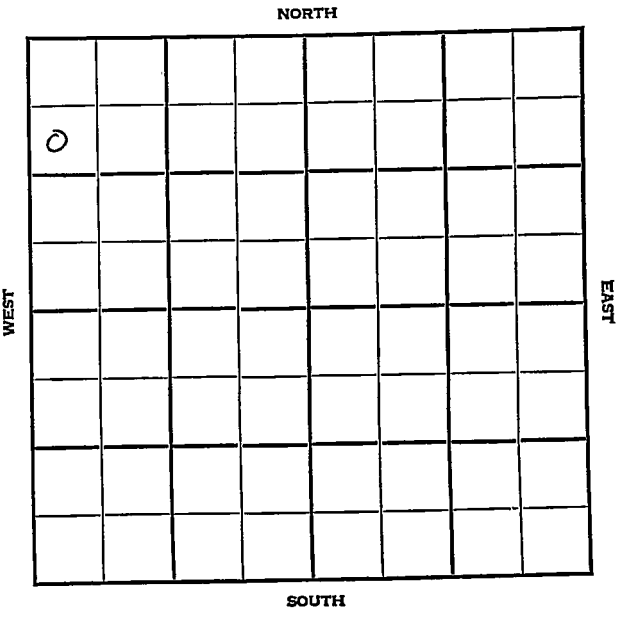

FORM 252-A
5M 4-48 PETROL

KANSAS Rooks ✓

Sec. 27 Twp. 8 R. 19W

Well No. #4 Green "A" Farm

W. L. Hartman Company

Webster Pool


990' Ft. from N. Line

Ft. from S. Line

Ft. from E. Line

330' Ft. from W. Line

SW NW NW

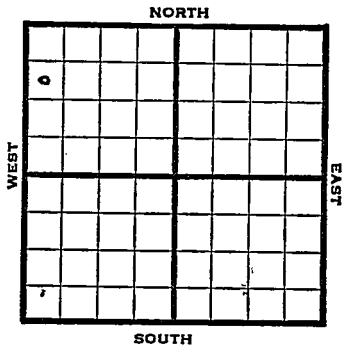

1948	Eli 1995' REPORT
7/21	Location
7/28	8"@ 138' Drlg 2730'
8/4	Lansing 3193' Arb. 3436-39' TD 3439' 5" @ 3437'
8/11	"
8/18	TD 3447 300 acid 266' oil
8/25	"
9/1	"
9/8	"
9/15	Arb 3436' TD 3447' 5"@ 3437' Pump 73 oil + 2% W Pot 28° Gr. Comp COMPLETED

Form 26—200 Bks.—1-48—Palace

Kansas Webster Pool

Map No. _____ Sec. 27 Twp. 8 R. 19W

Well No. 4 Green "A"

W. L. Hartman Company

FIRST REPORT

Contractor

SW NW NW


990 Ft. from N. Line

_____ Ft. from S. Line

_____ Ft. from E. Line

330 Ft. from W. Line

SECTION PLAT

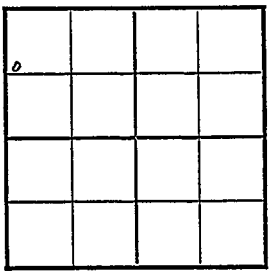

~~Rooks County~~

Location x

Rig up

Drilling and Remarks:

RECORD

Cased _____ in., _____ ft.

Sand

Gas

Oil

Total Depth

PRODUCTION

1st 24 hrs. Nat.

1st 24 hrs. after shot

Gas _____ Cu. Ft.

Dry Hole

Abandoned

Date

JUL 21 1948 19 S. J. LEWIS Scout

Form 27—100 Bks.—4-48—Petrol

Rooks County Kansas State

Map No. 6 C Sec. 27 Twp. 8 R. 19W

Well No. 4 Green "A"


W. L. Hartman Company

COMPLETE Contractor

SW NW NW

El. 1995

SECTION PLAT

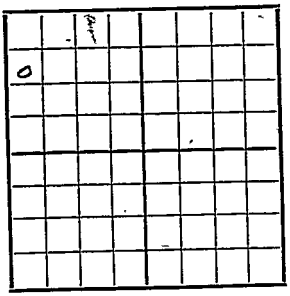

990 Ft. from N. Line

Ft. from S. Line

Ft. from E. Line

330 Ft. from W. Line

Webster Pool

Remarks:

Cr 43436

Y D3447

S "C3437

Pump 78 oil + 2 Tbl Pet

28° Gr

Date SEP 15 1948

Scout S. J. LEWIS