

KANSAS


FORM 51 5M 6-46 PETROL

Rooks county

Section 27 Township 8 Range 19-W

Well No. #2, Stice

Company Stanolind Oil and Gas Company

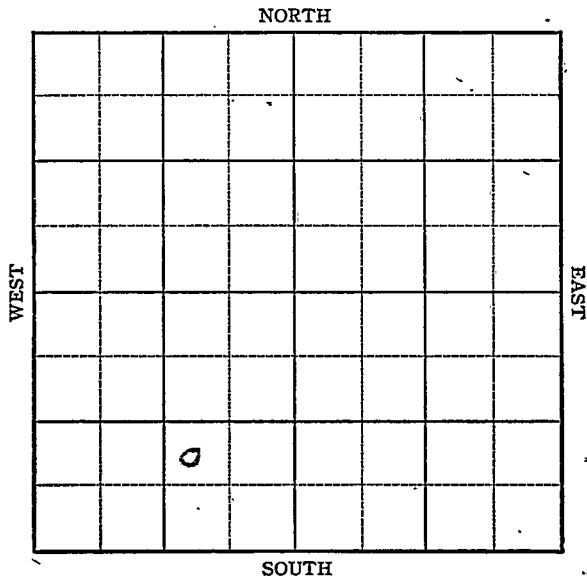

KANSAS

Rooks

Sec. 27 Twp. 8 R. 19W

Well No. 2 Stice Farm

Stanolind Company


Ververka

Ft. from N. Line

990 Ft. from S. Line

990 Ft. from E. Line

Ft. from W. Line

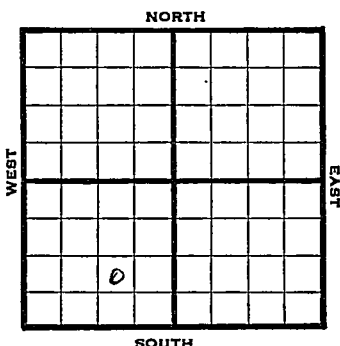

NW SE SW

1946

Elev. 1982'

REPORT

11/20 Location

11/27 13" @ 152 WOC

12/3 Anhy 1383
8" @ 1395'
Drlg 2655'

12/10 Lans 3135'
Arb 3400'
TD 3 405'
5" @ 3401, RUST

12/17 Swb 3 E/3 oil PH 5 hrs
1000 acid

1947

1/2 Arb 3400'
5" @ 3401'
TD 3405'
1000 Acid
Depth POT 2925'
27 Grav.

COMPLETED

Map No. 65 Sec. 27 Twp. 8 R. 19WWell No. 2 Stice

Stanolind Company

FIRST REPORT Contractor

NW SE SW

SECTION PLAT

	0		

 Ft. from N. Line990 Ft. from S. Line990 Ft. from E. Line Ft. from W. Line

Rooks County

Location XRig up

Drilling and Remarks:

RECORD

Cased in., ft.Sand Gas Oil Total Depth

PRODUCTION

1st 24 hrs. Nat. 1st 24 hrs. after shot Gas Cu. Ft.Dry Hole Abandoned

Date

NOV 20 1946

19

S. J. LEWIS Scout

Map No. 65 Sec. 27 Twp. 8 R. 19WWell No. 2 Stice


Stanolind

Company

COMPLETED

Contractor

NW SE SW

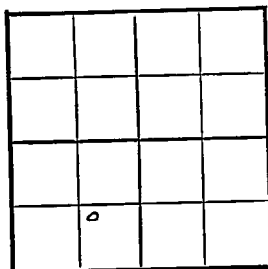E. 1, 1982
SECTION PLAT

Ft. from N. Line

990 Ft. from S. Line

990 Ft. from E. Line

Ft. from W. Line

Rooks County

Location

Rig up

Drilling and Remarks:

*Per # 3400**5" @ 3401, 10000 cu. ft.**Dep't # 2925**27 c. ft.*

RECORD

Cased _____ in., _____ ft.

Sand _____

Gas _____

Oil _____

Total Depth *3405*

PRODUCTION

1st 24 hrs. Nat. _____

1st 24 hrs. after shot _____

Gas _____ Cu. Ft.

Dry Hole _____

Abandoned _____

Date

JAN 2 1947

19

S. J. LEWIS, Scout