

Rooks


FORM 51 IOM 12-46 PETROL

KANSAS

Section 27 Township 8 Range 19W

Well No. 2 ³ Green "A"

Company W. L. Hartman

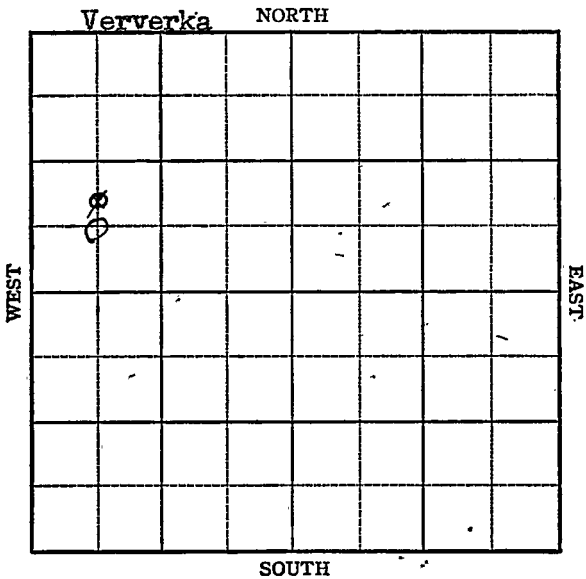

KANSAS

Rooks county ✓

Sec. 27 Twp. 8 R. 19W

Well No. #32 Green "A" Farm
W. L. Hartman Company

Ververka Pool

Ft. from N. Line

990


Ft. from S. Line

Ft. from E. Line

660

Ft. from W. Line

C N L S W NW

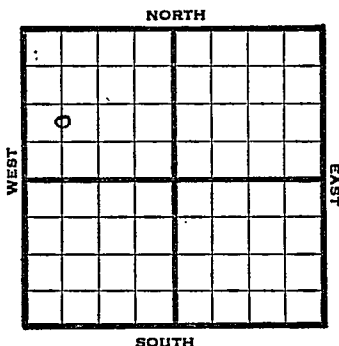

1947 Elev. 2001' REPORT

5/7	Location
5/13	"
5/20	"
5/27	"
6/3	"
6/10	"
6/21	"
6/24	"
7/1	"
7/8	"
7-16	"
7/22	"
7/29	Surface hole.
8/6	8" @ 180' Drlg 2690'
8/13	Lansing 3183 Arbuckle 3431 TD 3433 5" @ 3432' RUST,

OVER

1947

8/20 Lansing 3183
Arbuckle 3431
TD 3433, 5" @ 3432.
RUST

8/27 TD 3434
2700 oil 9 hrs.

9/3 "

9/10 "

9/17 "

9/24 "

10/1 Pump 12 oil PH 4% W 8 hrs.

10/8 "

10/15 Arbuckle 3431
5" @ 3432
Pump 178 oil & 20% W Pot.
TD 3434
Gravity 27

COMPLETED

Map No. K15 ^{Kansas} Sec. 27 Twp. 8 R. 19W

Well No. 2 Green

W. L. Hartman


Company

FIRST REPORT

Contractor

C N L SW NW

SECTION PLAT

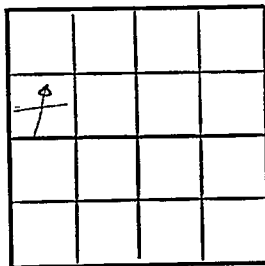

 Ft. from N. Line

990 Ft. from S. Line

 Ft. from E. Line

660 Ft. from W. Line

Rooks County

Location X

Rig up

Drilling and Remarks:

RECORD

Cased in., ft.

Sand

Gas

Oil

Total Depth

PRODUCTION

1st 24 hrs. Nat.

1st 24 hrs. after shot

Gas Cu. Ft.

Dry Hole

Abandoned

Date


MAY 7 1947 19

S. J. LEWIS Scout

Map No. 65 ^{Kansas} Sec. 27 Twp. 8 R. 19WWell No. 3 Green "A"W. L. Hartman CompanyCORRECTION Contractor

C N L SW NW

SECTION PLAT

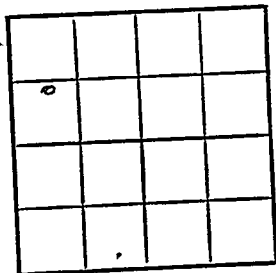 Ft. from N. Line990 Ft. from S. Line Ft. from E. Line660 Ft. from W. LineRooks CountyLocation Rig up

Drilling and Remarks:

Reported as
#2 Green

RECORD

Cased in., ft.Sand Gas Oil Total Depth

PRODUCTION

1st 24 hrs. Nat. 1st 24 hrs. after shot Gas Cu. Ft.Dry Hole Abandoned

Date

JUL 23 1947

19

S. J. LEWIS

Scout

Map No. 65 Sec. 27 Twp. 8 R. 19W


Well No. 3 Green "A"

W. L. Hartman Company

CORRECTION Contractor

C SW NW

SECTION PLAT

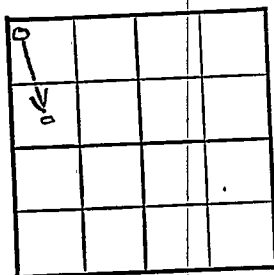

 Ft. from N. Line

660 Ft. from S. Line

 Ft. from E. Line

660 Ft. from W. Line

Rooks County

Location

Rig up

Drilling and Remarks:

Reported

C N L SW NW

RECORD

Cased in., ft.

Sand

Gas

Oil

Total Depth

PRODUCTION

1st 24 hrs. Nat.

1st 24 hrs. after shot

Gas Cu. Ft.

Dry Hole

Abandoned

Date

JUL 30 1947 19

S. J. LEWIS Scout

Ververka Pool


Form 26 200 Bks. 10-46 Petrol

Map No. 65 Sec. 27 Twp. 8 R. 19W

Well No. 3 Green "A"

W. L. Hartman Company

COMPLETE Contractor
C SW NW E1,200?
SECTION FLAT

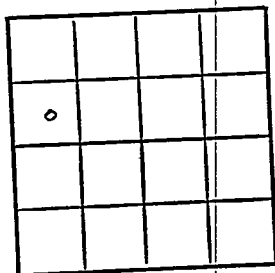

 Ft. from N. Line
660 Ft. from S. Line
 Ft. from E. Line
660 Ft. from W. Line

Rocks County

Location

Rig up

Drilling and Remarks:

Cor 83431

5" Cor 432

Pump 175 oil 7

20% W. Prod

27 2/3

RECORD

Cased in., ft.

Sand

Gas

Oil

Total Depth 3424

PRODUCTION

1st 24 hrs. Nat.

1st 24 hrs. after shot

Gas Cu. Ft.

Dry Hole

Abandoned

Date

OCT 15 1947 19

S. J. LEWIS

Scout