

Rooks County


FORM 51 10M 8-47

KANSAS

Section 27 Township 8 Range 19W

Well No. 1 Stice

Company Jones & Shelborne

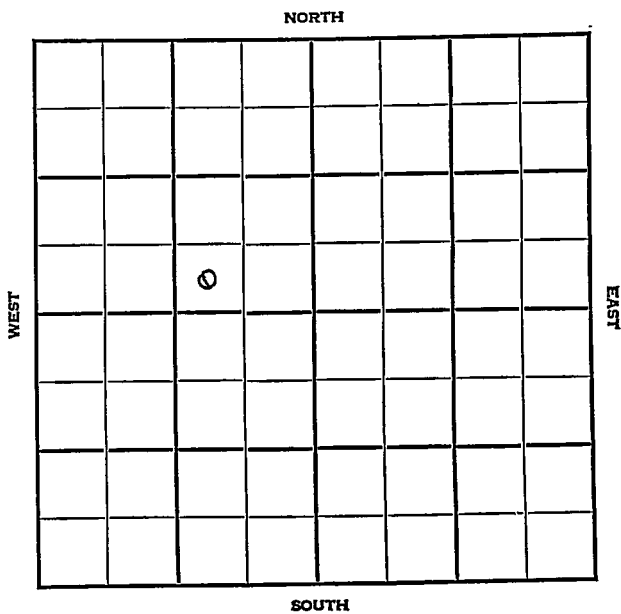

Rooks KANSAS



Sec. 27 Twp. 8 R. 19W

Well No. #1 Stice Farm

Jones & Shelborne Company


Webster

 Ft. from N. Line

330 Ft. from S. Line

990 Ft. from E. Line

 Ft. from W. Line

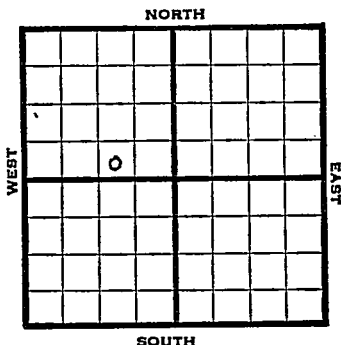

SW SE NW

1947

Elev. 1977' REPORT

12/17 Surface hole.

12/30 8" @ 270'
Anhy. 1390'
Lans. 3144'
Drlg. 3340'

1948

1/7 Simp Sd. 3386'
Arbuckle 3419'
Total Depth 3490'

ABANDONED

Form 26 200 Bks. 10-46 Petrol
Kansas

Webster Pool

Map No. _____ Sec. 27 Twp. 8 R. 19W

Well No. 1 Stice

Jones & Shelborne


Company

FIRST REPORT

Contractor

SW SE NW

SECTION PLAT

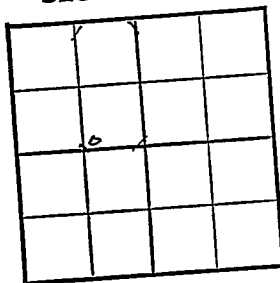

_____ Ft. from N. Line

330 Ft. from S. Line

990 Ft. from E. Line

_____ Ft. from W. Line

Rooks County

Location _____

Rig up _____

Drilling and Remarks:

surface hole

RECORD

Cased _____ in., _____ ft.

Sand _____

Gas _____

Oil _____

Total Depth _____

PRODUCTION

1st 24 hrs. Nat. _____

1st 24 hrs. after shot _____

Gas _____ Cu. Ft.

Dry Hole _____

Abandoned _____

Date

DEC 17 1947 19

S. J. LEWIS

Scout

Webster Pool

Map No. 65 Sec. 27 Twp. 8 R. 19W

Well No. 1 Stice

Jones & Shelborne Company

ABANDONED

Contractor

SW SE NW

F11927
SECTION PLAT

 Ft. from N. Line

330 Ft. from S. Line

990 Ft. from E. Line

 Ft. from W. Line

Rooks County

Location

Rig up

Drilling and Remarks:

Surf Set 3386

Re 8419

RECORD

Cased in., ft.

Sand

Gas

Oil

Total Depth 2490

PRODUCTION

1st 24 hrs. Nat.

1st 24 hrs. after shot

Gas Cu. Ft.

Dry Hole

Abandoned

Date

JAN 7 1948 19

S. J. LEWIS Scout