


Section 27 Township 8 Range 19W

Well No. 3 Stice

Company Stanolind

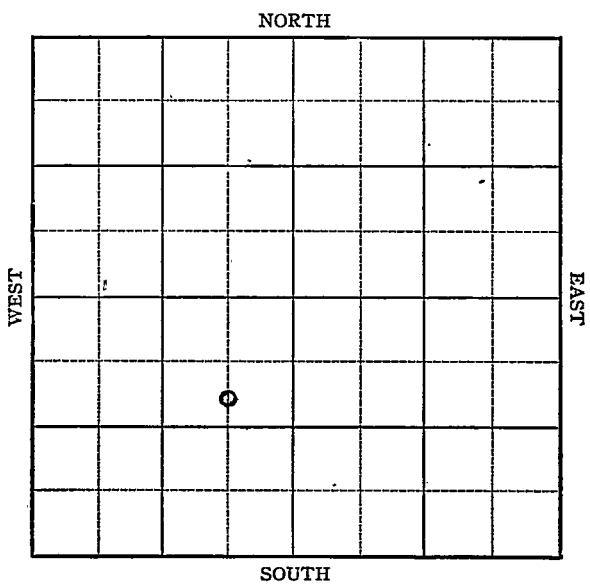

KANSAS

Sec. 27 Twp. 8 R. 19-W ✓


Well No. #3 Stice Farm  
Stanolind Company

990 Ft. from N. Line

\_\_\_\_\_ Ft. from S. Line

660 Ft. from E. Line

\_\_\_\_\_ Ft. from W. Line

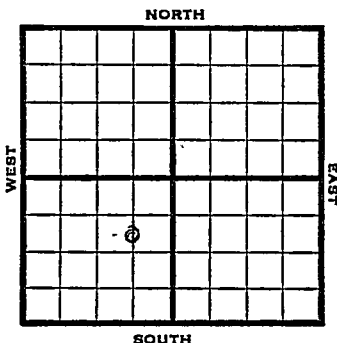

C S L NE SW

REPORT

1947 Elev. 1977

2/26 RUR

3/4 13" @ 159  
Drlg 1285'

3/11 Drlg 2856'

3/26 Arb 3401  
5" @ 3401  
500 Acid  
Depth Pot 3278  
Wax 3000  
Grav. 25  
TD 3405'

**COMPLETED**

Map No. 65 Sec. 27 Twp. 8 R. 19W

Well No. 3 Stice

Stanolind Company

**FIRST REPORT** Contractor

C S L NE SW

**SECTION PLAT**

990 Ft. from N. Line

         Ft. from S. Line

660 Ft. from E. Line

         Ft. from W. Line


Rooks County

**RECORD**

Location                                 

Cased          in.,          ft.

Rig up                                 

Sand                                 

Drilling and Remarks:

Gas                                 

R U R

Oil                                 

Total Depth                         

**PRODUCTION**

1st 24 hrs. Nat.                         

1st 24 hrs. after shot                         

Gas                                  Cu. Ft.

Dry Hole                                 

Abandoned                                 

Date

FEB 26 1947 19

S. J. LEWIS Scout

