

KANSAS


FORM 51 5M 11-44 PETROL

Rooks County

Section 27 Township 8 Range 19W

Well No. #1 Ververka

Company Bird & Boreing

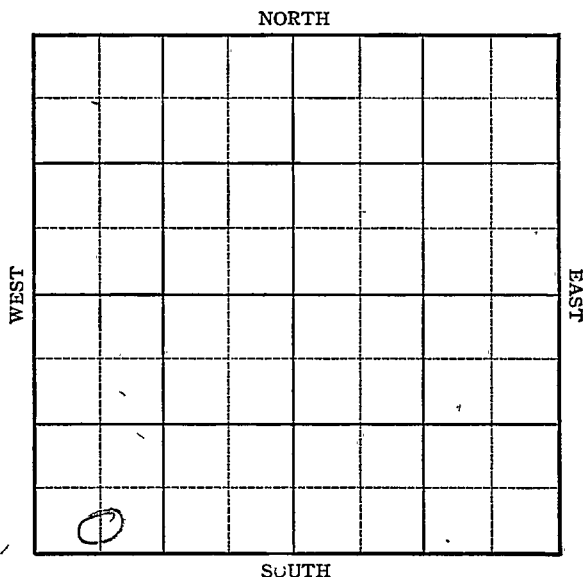

KANSAS

Sec. 27 Twp. 8 R. 19WWell No. #1 Ververka FarmBird & Boreing Company

Wildcat


Ft. from N. Line

330 Ft. from S. Line

Ft. from E. Line

660 Ft. from W. Line

CSL SW SW

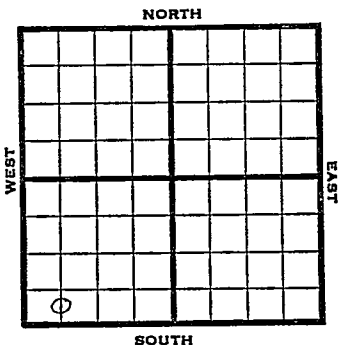

1946 Elev. 1974' REPORT

2/6 Surface Hole
2/14 8" - 225' Anhy 1389'
Drlg. 2483'
2/21 Lans. 3140' Arb. 3403'
T.D. 3407' 5" - 3404'
RUST.
2/28 T.D. 3409' 2650' oil in 24 hours.
23.3 Gravity
3/4 Swab 27½ oil 1 hour.
3/14 " " "
3/21 " " "
3/28 Pump 6½ oil per hour.

4/3 Arb. 3403
5" @ 3404
TD 3409
Echo Pot. 2549
Grav. 22.0

COMPLETED

Kansas Pool Name Wildcat
 Map No. 63 Sec. 27 Twp. 8 R. 19W

Well No. 1 Ververka

Bird & Boreing _____ Company

FIRST REPORT _____ Contractor

C S L SW SW

SECTION PLAT

_____ Ft. from N. Line

330 Ft. from S. Line

_____ Ft. from E. Line

660 Ft. from W. Line

Rooks County

Location _____

Rig up _____

Drilling and Remarks:

surface hole

RECORD

Cased _____ in., _____ ft.

Sand _____

Gas _____

Oil _____

Total Depth _____

PRODUCTION

1st 24 hrs. Nat. _____

1st 24 hrs. after shot _____

Gas _____ Cu. Ft.

Dry Hole _____

Abandoned _____

Date

FEB 6 1946 19

S. J. LEWIS

Scout

ANSAS Kansas Pool Name Webster

Map No. 65 Sec. 27 Twp. 8 R. 19W

Well No. 1 Ververka

Bird & Boreing Company

COMPLETED

Contractor

C S L SW SW

E 11774
SECTION PLAT

6			

Ft. from N. Line

330 Ft. from S. Line

Ft. from E. Line

660 Ft. from W. Line

Rooks County

Location

Rig up

Drilling and Remarks:

Cat 8443

5" C 3404

E 11774 2549.

22 1/2 in.

RECORD

Cased in, ft.

Sand

Gas

Oil

Total Depth 3409

PRODUCTION

1st 24 hrs. Nat.

1st 24 hrs. after shot

Gas Cu. Ft.

Dry Hole

Abandoned

Date

APR 3 1946

19

S. J. LEWIS

Scout