

KANSAS


FORM 51 IOM 12-46 PETROL

Rooks county

Section 27 Township 8 Range 19-W

Well No. #3, Ververka

Company Bird and Boreing

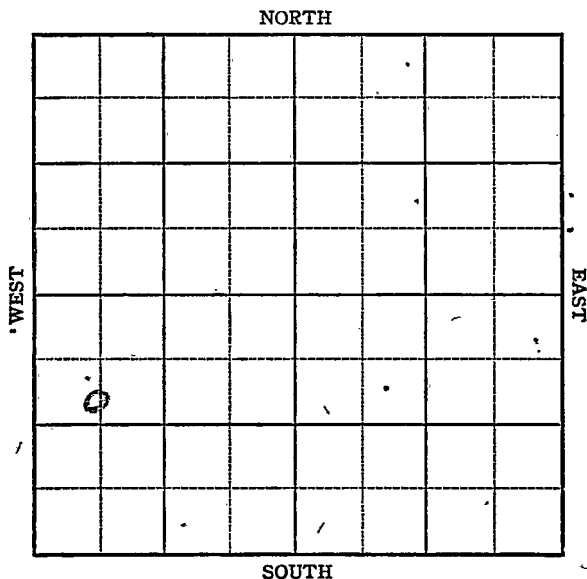

KANSAS

Rooks County

Sec. 27 Twp. 8 R. 19W

Well No. 3 Ververka Farm
Bird & Boreing Company


Ververka Pool

990 Ft. from N. Line

Ft. from S. Line

Ft. from E. Line

660 Ft. from W. Line

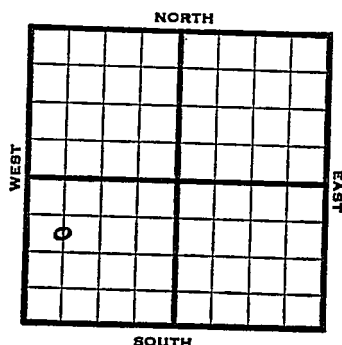

C S L NW SW

1947

Elev. 1990

REPORT

1/2

Lans 3120'

Bks 3360'

SO 3223-3229'

3308-3340'

Arb 3383'

TD 3387'

5" @ 3383' RUST

1/8

"

"

1/15

Arb 3403 Corrected

5" @ 3403

TD 3407-2735' oil-500 acid

1/21

Pump 22 oil

PH 4 hrs

2/5

TD 3407'

Arb 3404

5" @ 3403

500 Acid

Echo Pot 2083 oil

T 22% W

Grav. 27

COMPLETED

Kansas KANSAS

Map No. 65 Sec. 27 Twp. 8 R. 19WWell No. 3 Ververka

Bird & Boreing _____ Company

FIRST REPORT

Contractor _____

C S L NW SW

SECTION PLAT

o			

990 Ft. from N. Line Ft. from S. Line Ft. from E. Line660 Ft. from W. Line

Rooks County

Location _____

Rig up _____

Drilling and Remarks:

Lans. 3120

B KC 3360

SO, 3223-29

3308-40

Arb. 3383

TD 3387

5" @ 3383 RUST $\frac{1}{4}$

RECORD

Cased _____ in., _____ ft.

Sand _____

Gas _____

Oil _____

Total Depth _____

PRODUCTION

1st 24 hrs. Nat. _____

1st 24 hrs. after shot _____

Gas _____ Cu. Ft.

Dry Hole _____

Abandoned _____

Date

JAN 2 1947

19

S. J. LEWIS

Scout

Form 26 200 Bks. 10-46 Petrol
Kansas

Ververka Pool

Map No. 65 Sec. 27 Twp. 8 R. 19W

Well No. 3 Ververka

Bird & Boreing


Company

COMPLETE

Contractor

C S L NW SW

E 11, 1990
SECTION PLAT

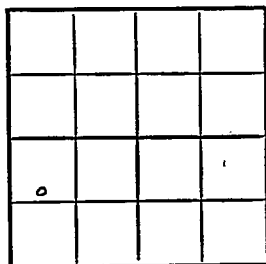

990 Ft. from N. Line

 Ft. from S. Line

 Ft. from E. Line

660 Ft. from W. Line

Rooks County

RECORD

Location

Rig up

Drilling and Remarks:

Cased in., ft.

Sand

Gas

Oil

Total Depth 3407

PRODUCTION

1st 24 hrs. Nat.

1st 24 hrs. after shot

Gas Cu. Ft.

Dry Hole

Abandoned

279 1/2

Date

FEB 5 1947 19

S. J. LEWIS

Scout