


KANSAS Rocks

Section 27 Township 8 Range 19W

Well No. 4 Ververka

Company Bird & Boreing

• Ververka

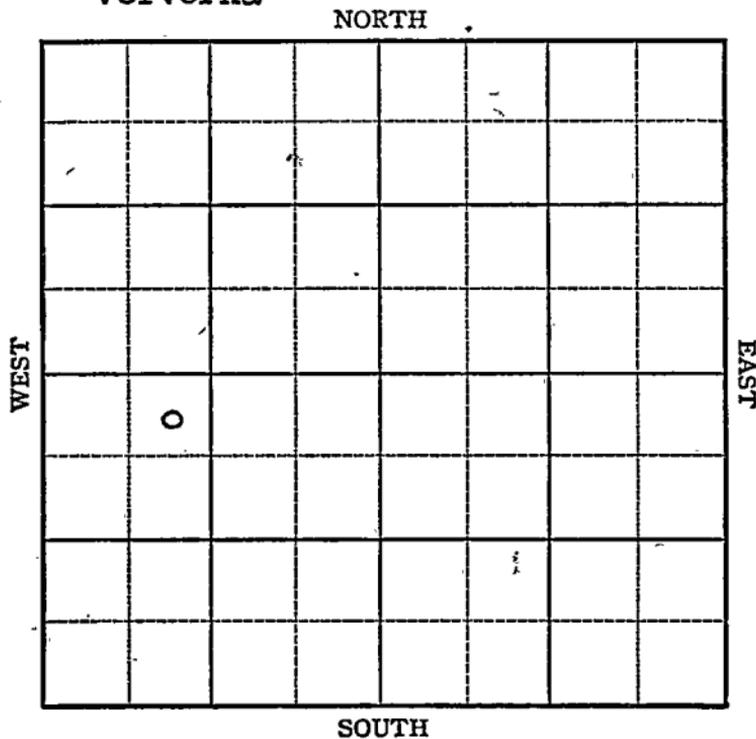

Sec. 27 Twp. 8 R. 19-W

Well No. #4 Ververka Farm


Bird & Doring Company

330 Ft. from N. Line

_____ Ft. from S. Line

_____ Ft. from E. Line

990 Ft. from W. Line

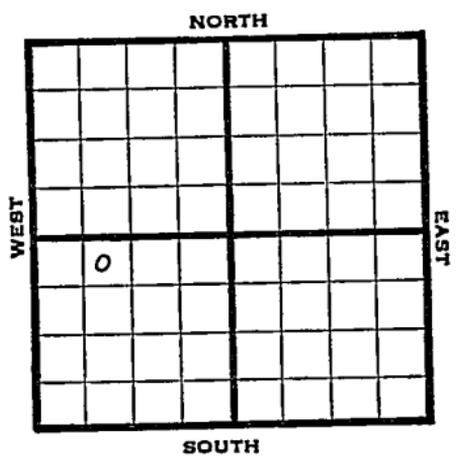

NE NW SW

1947 Elev. 1953' REPORT

4/9	8" set 256' Drlg. 2225'
4/16	Lansing 3144' Arbuckle 3415' TD 3416' 5" @ 3416' RUST
4/23	TD 3416' Swb 16 bbls oil PH
4/29	TD 3417' 500 Acid Shot 21 bbls. oil pr hour 4 hrs.
5/7	" " "
5/13	" " "
5/21	Arb 3415 5" @ 3416' 500 acid Pump 116 oil & 30% water Pot Grav. 27 TD 3417'

COMPLETED

KANSAS

Ververka Pool

Kansas

Map No. K65 Sec. 27 Twp. 8 R. 19W

Well No. 4 Ververka

Bird & Boring Company

FIRST REPORT Contractor

NE NW SW


SECTION PLAT

330 Ft. from N. Line

_____ Ft. from S. Line

_____ Ft. from E. Line

990 Ft. from W. Line

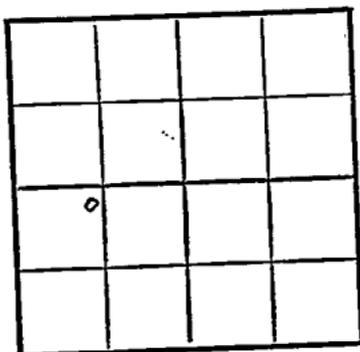

Rooks County

Location _____

Rig up _____

Drilling and Remarks:

8" @ 256

drlg. 2225

RECORD

Cased _____ in., _____ ft.

Sand _____

Gas _____

Oil _____

Total Depth _____

PRODUCTION

1st 24 hrs. Nat. _____

1st 24 hrs. after shot _____

Gas _____ Cu. Ft.

Dry Hole _____

Abandoned _____

Date

APR 9 1947 19

S. J. LEWIS Scout

Map No. K65 Sec. 27 Twp. 8 R. 19W

Well No. 4 Ververka

Bird & Boreing Company
COMPLETE


Contractor

E.I. 1988

NE NW SW

SECTION PLAT

330 Ft. from N. Line
 Ft. from S. Line
 Ft. from E. Line
990 Ft. from W. Line

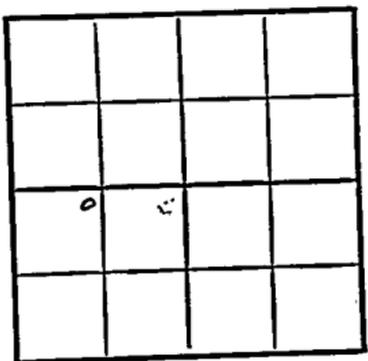

Rooks County

RECORD

Location _____

Cased _____ in., _____ ft.

Rig up _____

Sand _____

Drilling and Remarks:

Gas _____

*CR 3415
5" @ 3416
500 acid
Pump 116 oil +
30% water pad*

Oil _____

Total Depth 3417

PRODUCTION

1st 24 hrs. Nat. _____

1st 24 hrs. after shot _____

Gas _____ Cu. Ft.

Dry Hole _____

Abandoned _____

27 9/12

Date

MAY 21 1947 19

S. J. LEWIS

Scout

check up

L
2/27/77

1st report shows
has well spotted
no news.

admission
San

Misc. Small Maps	<input checked="" type="checkbox"/>
Cards	<input checked="" type="checkbox"/>
Tracing	<input checked="" type="checkbox"/>
France Map	<input checked="" type="checkbox"/>
Scarborough Map	<input checked="" type="checkbox"/>
Pierce Map	<input checked="" type="checkbox"/>
Geological Dept.	<input type="checkbox"/>
Pierce Plat Book	<input type="checkbox"/>