

KANSAS

Section 27 Township 8 Range 20W

Well No. 1 Morin

Company Harry Gore

Wildcat
NORTH

							0

WEST

EAST

SOUTH

KANSAS

Rooks

Sec. 27 Twp. 8 R. 20W ✓

Well No. #1 Morin Farm

Harry Gore Company

Wildcat


330' Ft. from N. Line

_____ Ft. from S. Line

330' Ft. from E. Line

_____ Ft. from W. Line

NE/C

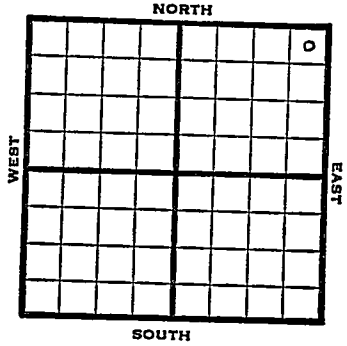

1948

REPORT

10/20

Location
Aband.

ABANDONED

Wildcat

Map No. 65 Sec. 27 Twp. 8 R. 20W

Well No. 1 Morin

Harry Gore

Company

ABANDONED

Contractor

NE/C

SECTION PLAT

330 Ft. from N. Line
 Ft. from S. Line
330 Ft. from E. Line
 Ft. from W. Line

				3

Rooks County

Location X

Rig up

Drilling and Remarks:

RECORD

Cased in., ft.
Sand
Gas
Oil
Total Depth

PRODUCTION

1st 24 hrs. Nat.
1st 24 hrs. after shot
Gas Cu. Ft.
Dry Hole
Abandoned

Date

OCT 20 1948

19

S. J. LEWIS

Scout

Map No. _____ Sec. 27 Twp. 8 R. 20W

Well No. 1 Morin

Harry Gore Company

FIRST REPORT

Contractor

NE/C

SECTION PLAT

330 Ft. from N. Line

_____ Ft. from S. Line

330 Ft. from E. Line

_____ Ft. from W. Line

				5

Rooks County

Location X

Rig up _____

Drilling and Remarks:

RECORD

Cased _____ in., _____ ft.

Sand _____

Gas _____

Oil _____

Total Depth _____

PRODUCTION

1st 24 hrs. Nat. _____

1st 24 hrs. after shot _____

Gas _____ Cu. Ft.

Dry Hole _____

Abandoned _____

Date

OCT 20 1948 19

S. J. LEWIS Scout