

Graham

DX 78-1


KANSAS

Section 27 Township 8 Range 21W

Well No. #1 Newell

Company Schermerhorn Oil

NORTH

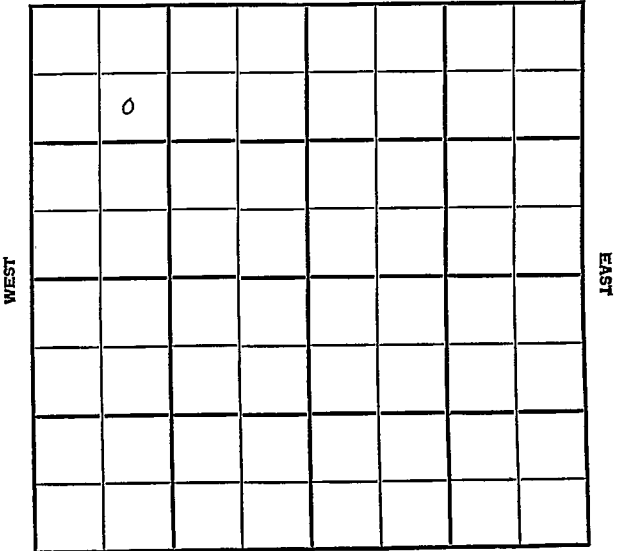

SOUTH

Graham KANSAS

SEC.	TWP.	R.
27	8	21W

WELL NO.

1 Newell

FARM

COMPANY

Schermerhorn Oil

CONTRACTOR

Badger


Wildcat

990 Ft. from N. Line

Ft. from S. Line

Ft. from E. Line

990 Ft. from W. Line

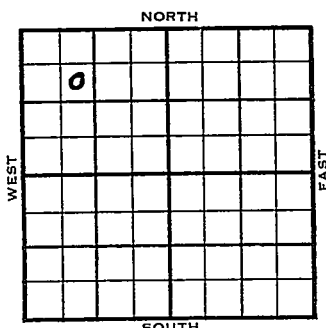

SE NW NW


Mid States FO

	ELEVATION	REPORT
1954	2108'	
8-25 11/3	Location Spud 9-3-54 Oil Well TD 3690' 8-5/8" @ 200' Anhy 1615', Top 3061', DST 3199'-3237' opn 1 hr, rec 360' muddy s.w. 900# Heeb 3274', Tor 3299' Lans 3315' DST 3304'-70' opn 2 hr, rec 70' socm 240' hocm, 1140# DST 3378'-3405' opn 1hr, rec 115' vhocm 1200# DST 3439'-82' opn 1/2 hr, rec 25' Mud 0# DST 3481'-3520' opn 1 hr rec 50' vsocm 730# Cong 3616', Arb 3664' TD 3690' 5" @ 3462' CO 3/ 3404-06 5 to 10 gw scum oil PB 3402' 6/ 3400-02 dry 18/ 3397-3400 350 M-A 1/4 bo 12 hr. PB 3395 42/ 3387-93 3/4 bo 500 A S/ 10 boph Comp 166 bopd.	

COMPI ETED

FABEN GILSTRAP

County Graham State Kansas
 Sec. 27 (Blk.) 8 (Sur.) 21W Map No. 8
 Operator Schermerhorn Oil
 Well No. 1 Farm Newell
 Elev. 2108 Location SE NW NW

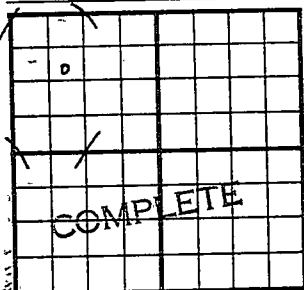

990 Ft. From N Line NW
990 Ft. From W Line Quarter
 1st. Report
 Completion NOV 3 1954
 Remarks Wildcat
Badger - Contr.
 Spudding Date 9-3-54

Drilg. Data Oil well TD 3690
8 5/8" @ 200 Anhy 1615 Top. 3061
DST 3199-3237 open 1 hr. Rec. 360'
muddy sw 900# Heeb. 3274 Tor. 3299
Lans. 3315 DST 3304-70 open 2 hr.
Rec. 70' socm 240' hocm 1140#
DST 3378-3405 open 1 hr. Rec. 115' vhoocm
1200# DST 3439-82 open 1/2 hr. Rec.
25' mud 0# DST 3481-3520 open 1 hr.
Rec. 50' vsocm 730# Cong. 3616
Arb. 3664 TD 3690 5" @ 3462 CO
3/ 3404-06 5 to 10 gw scum oil PB 3402
6/ 3400-02 dry 18/ 3397-3400 350 M-A
1/4 bo 12 hr. PB 3395 42/ 3387-93
3/4 bo 500 A S/ 10 boph
 Comp. 166 bopd **FABEN GILSTRAP**